


T.13&14S.,R.33E.,W.M.

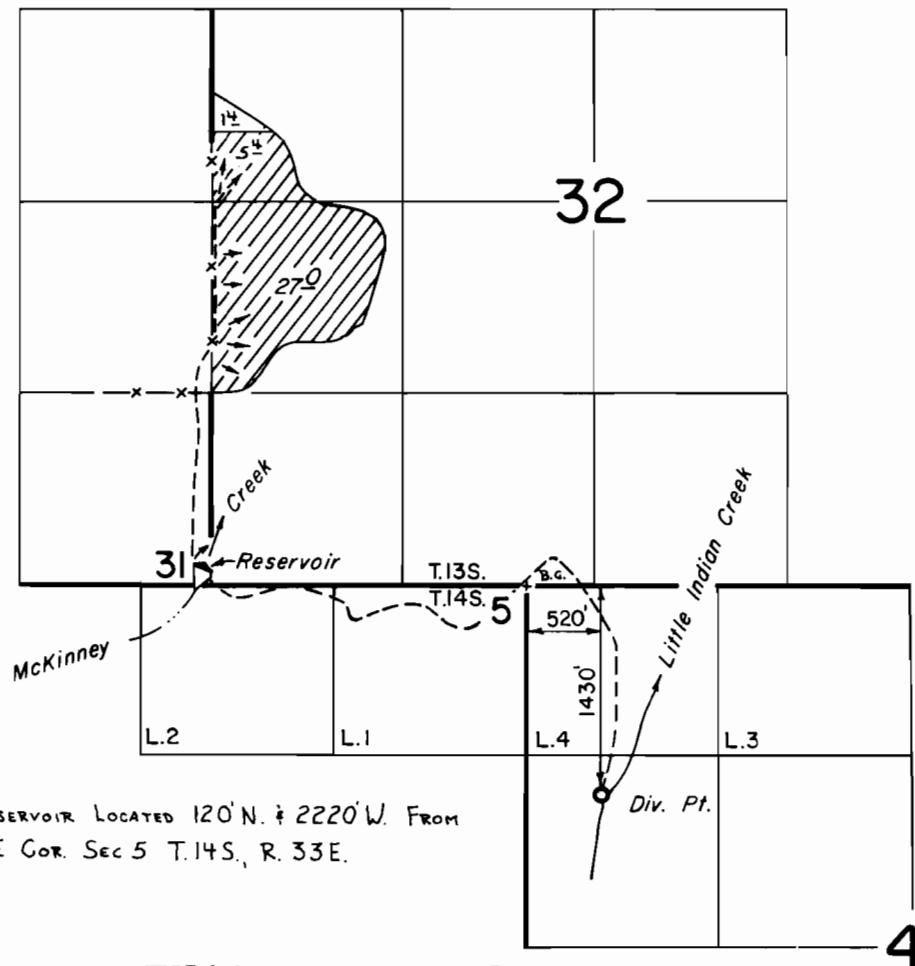

RESERVOIR LOCATED 120' N. & 2220' W. FROM
NE COR. SEC 5 T.14S., R. 33E.

FINAL PROOF SURVEY UNDER

R-52394
- 52820

R-6323
39463

Application No. 54931... Permit No. 41200...

IN NAME OF

HENRY H. BLAGDEN

Surveyed JUNE 14, 1980, by *H. Blagden*.....