


T.13&14S., R.33E., W.M.

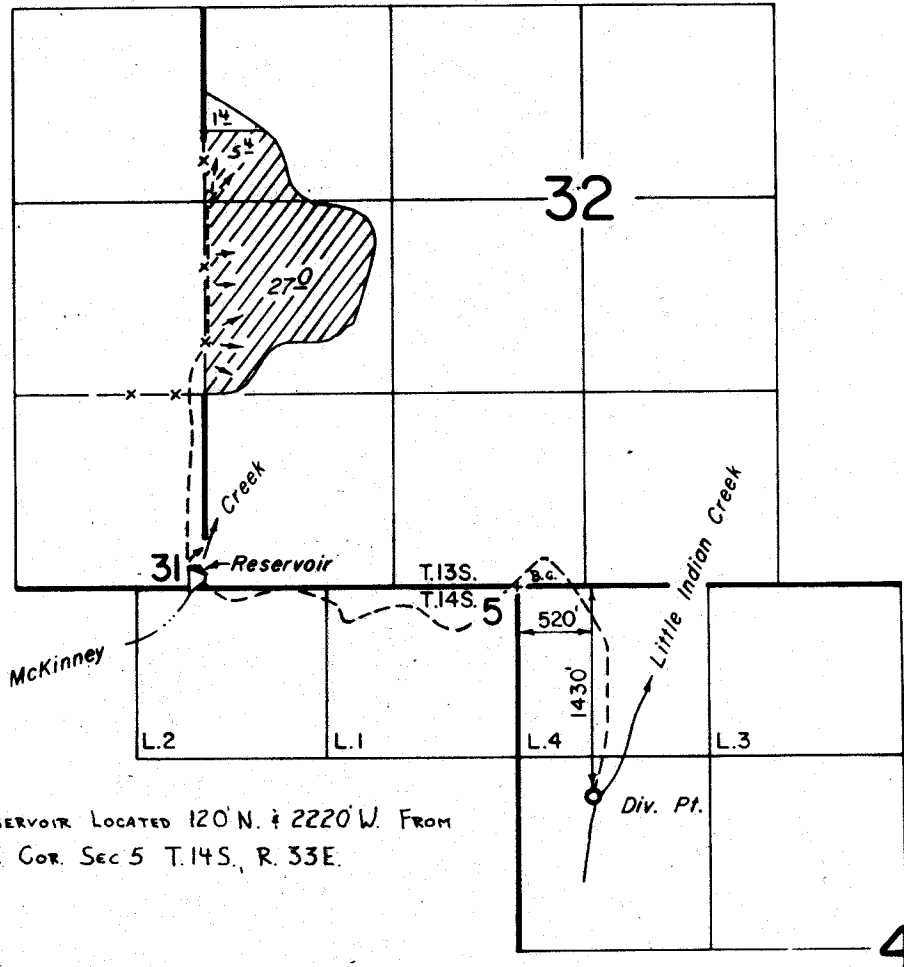

RESERVOIR LOCATED 120' N. & 2220' W. FROM  
NE COR. SEC 5 T.14S., R. 33E.

# FINAL PROOF SURVEY

UNDER

R-52394  
52820

R-6323  
39463

Application No. 54931 Permit No. 41200

IN NAME OF

HENRY H. BLAGDEN

Surveyed JUNE 14, 1980, by *H. Blagden*