


T.36S., R.1E., W.M.

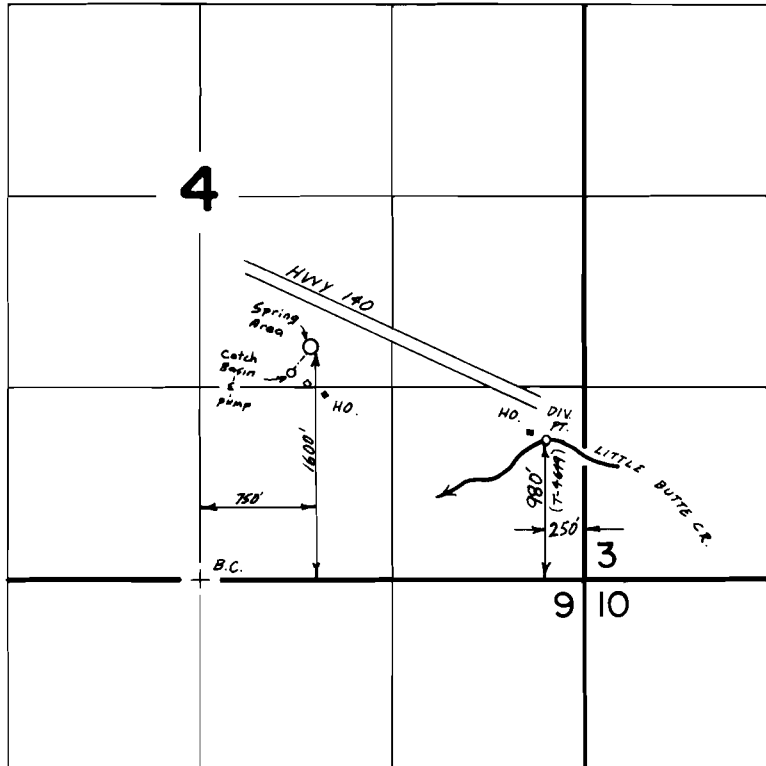

Scale : 1" = 1320'

FINAL PROOF SURVEY
UNDER

Transfer No. 4649

Application No. 61014.... Permit No. 45316.....
IN NAME OF

JOHNNY A. & or DOROTHY DODSON

Surveyed JUNE 12 1984, by B.S. JAMES.....