


T. 39 S., R. 8 W., W.M.

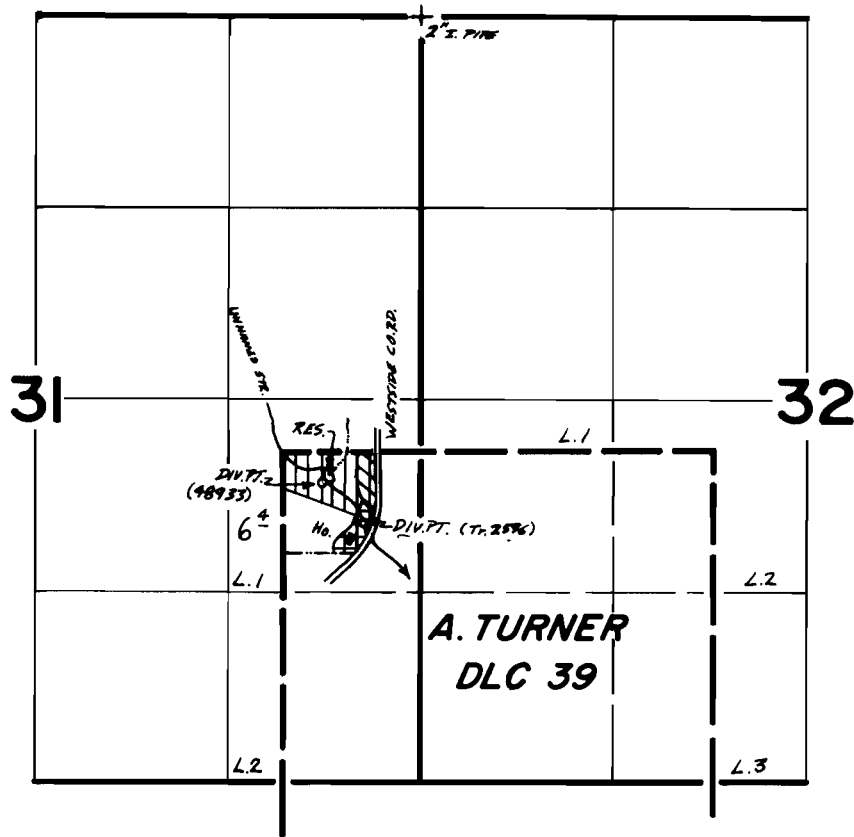

Scale: 4" = 1 mile

- Cert. 45765 = 1 ¹⁷/₁₇ ac.
- Tr.No. 2596 = 1 ¹/₁ ac.
- 48933 = primary ⁴/₁₃
suppl. ²/₂₇

FINAL PROOF SURVEY UNDER

Transfer No. 2596

R-48932 R-5936

Application No. 48933 Permit No. 36643....

IN NAME OF

.....CARL B. JACOBSON.....

Surveyed May...1... 1980, by B.R.SUND.....