


T. 34S., R. 7W., W.M.

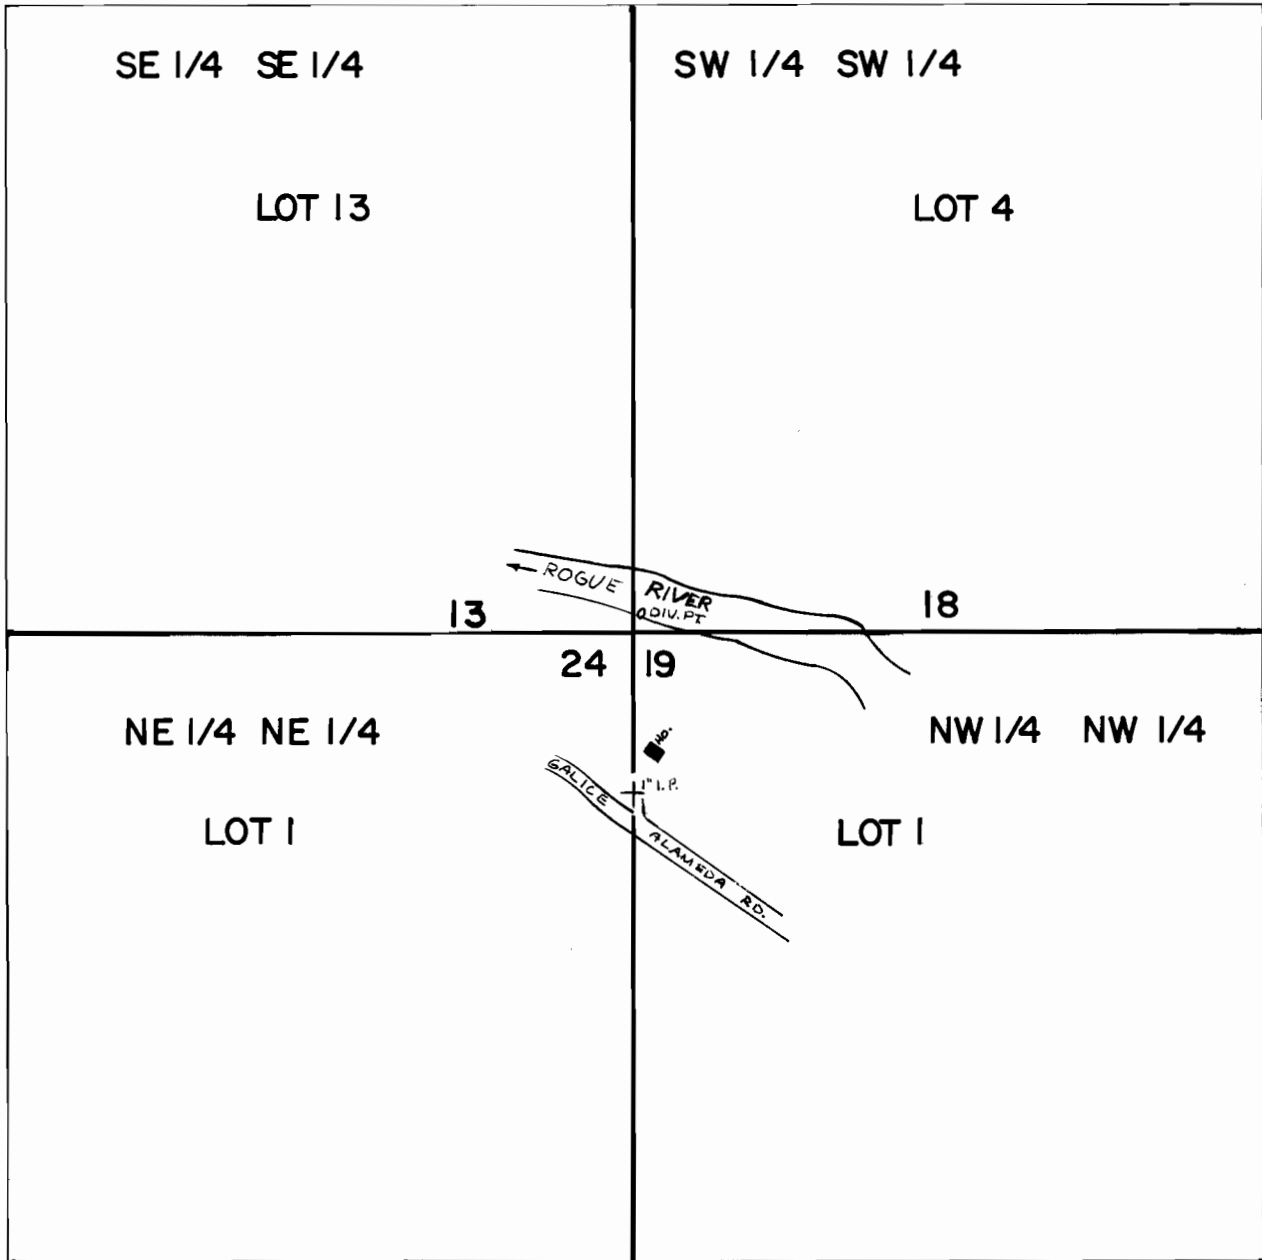

DIV. PT.: 40' N. & 15' E. FROM NW. COR. SEC. 19

SCALE 1" = 400'

FINAL PROOF SURVEY

UNDER

Application No. 50419 Permit No. 38050

IN NAME OF

MARK GORDON MINNIS

Surveyed JUNE 27 1984, by B. S. JAMES