


T. 40S., R. 18 & 19E., W.M.

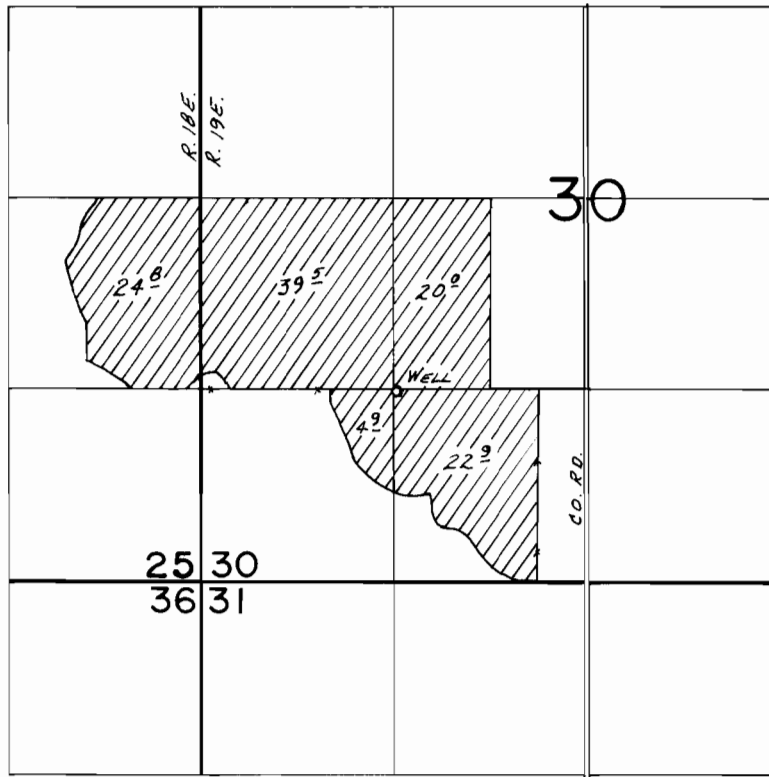

WELL LOC.: 1310' N. & 1330' E. FROM SW COR. SEC. 30

SCALE: 1" = 1320'

FINAL PROOF SURVEY
UNDER

Application No. G-8299. Permit No. G-7697.....
IN NAME OF

.....TERRY VANDEVER.....

Surveyed June 25, 1984, by B.W. BISHOP.....