


G-8874
53148

TOTAL P.02

T.24S., R.18E., W.M.

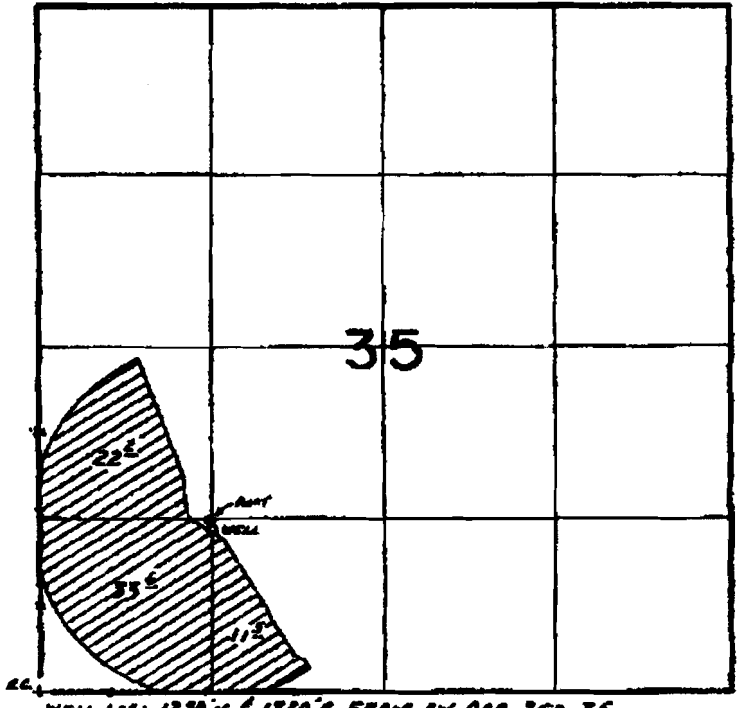

FINAL PROOF SURVEY UNDER

Application No. G-9453 Permit No. G-8874
IN NAME OF

ROBERT L. STOCKHOFF

Surveyed OCT. 15, 1984, by B.W. BISHOP

Pys 1244-1