


G.8884
53149

T.25S., R.18E., W.M.

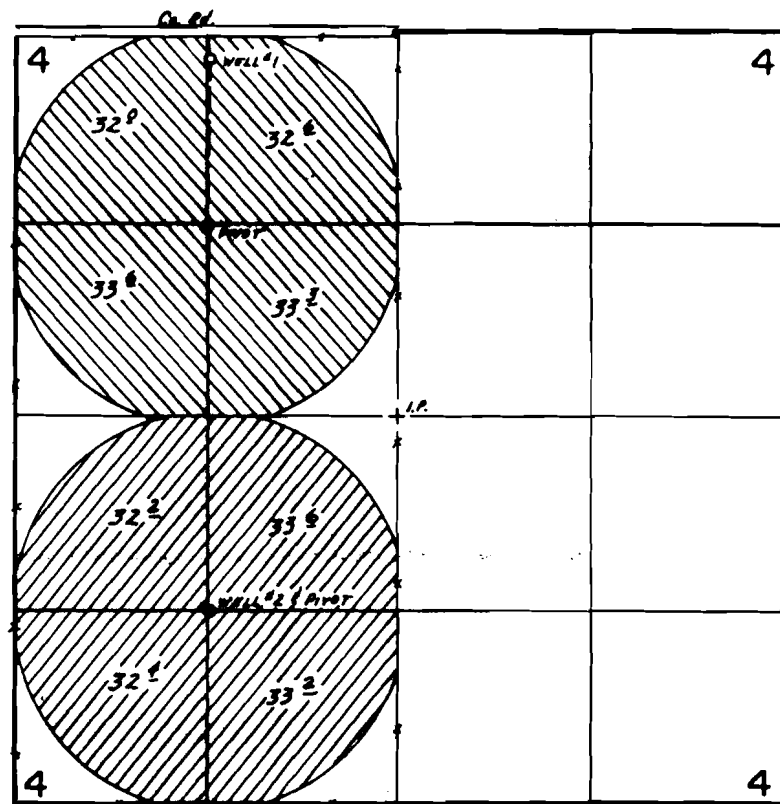

WELLS LOC: #1-180'S. f 1340'E, #2-8360'S. f 1350'E, BOTH FROM THE NW COR. SEC. 4.

 WELL No. 1
 WELL No. 2

SCALE: 1"=1320'

FINAL PROOF SURVEY UNDER

Application No. G-9827... Permit No. G-8884.....
IN NAME OF

.....VERNON D. HOUSTON.....

Surveyed OCT. 27... 1984, by B.W. BISHOP.....