


G-9176
53151

T. 26 S., R. 16 E., W. M.

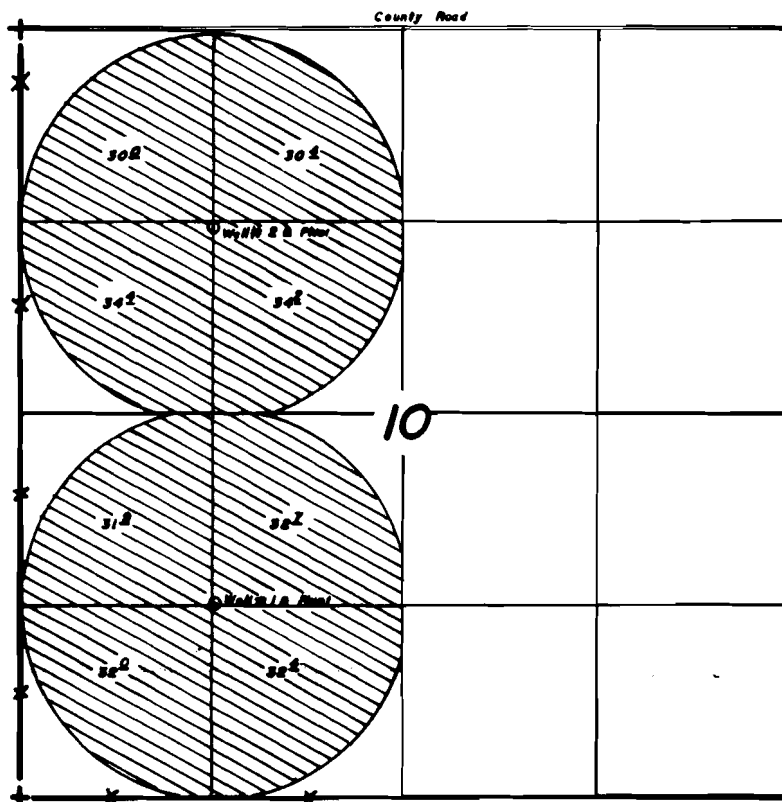

Well # 1 Located 1330' N. & 1330' E. from SW Cor. Sec. 10.

Well # 2 Located 1350' S. & 1320' E. from NW Cor. Sec. 10.

1" = 1320'

FINAL PROOF SURVEY
UNDER

Application No. **G-10162**. Permit No. **G-9176**....
IN NAME OF

FRANK E. & KATHLEEN ST. CLAIR

Surveyed **Nov. 1**..... 19**84**., by **Ben. Bishop**.....