


T.24S., R.18E., W.M.

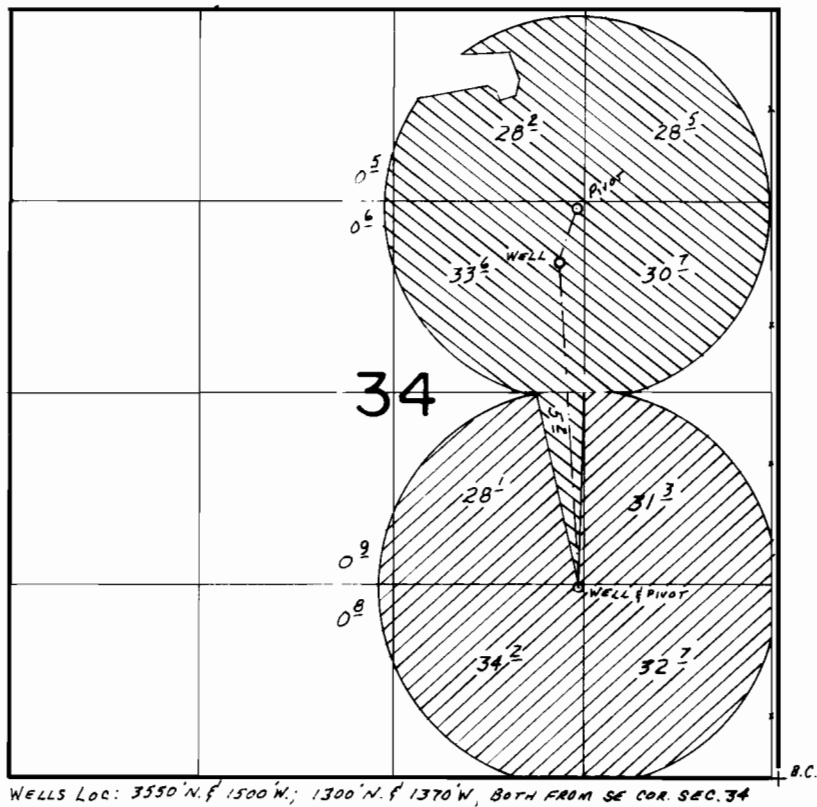

WELLS LOC: 3550' N. & 1500' W.; 1300' N. & 1370' W., BOTH FROM SE COR. SEC. 34

SCALE: 1"=1320'

## FINAL PROOF SURVEY UNDER

G-10250                      G-9292  
Application No. G-10252. Permit No. G-9293.....  
IN NAME OF



.....960 RANCH INC.....

Surveyed OCT. 14.... 1984, by B.W. BISHOP.....