


G. 9292 53152¹²
 G. 9293
 53153

T.24S., R.18E., W.M.

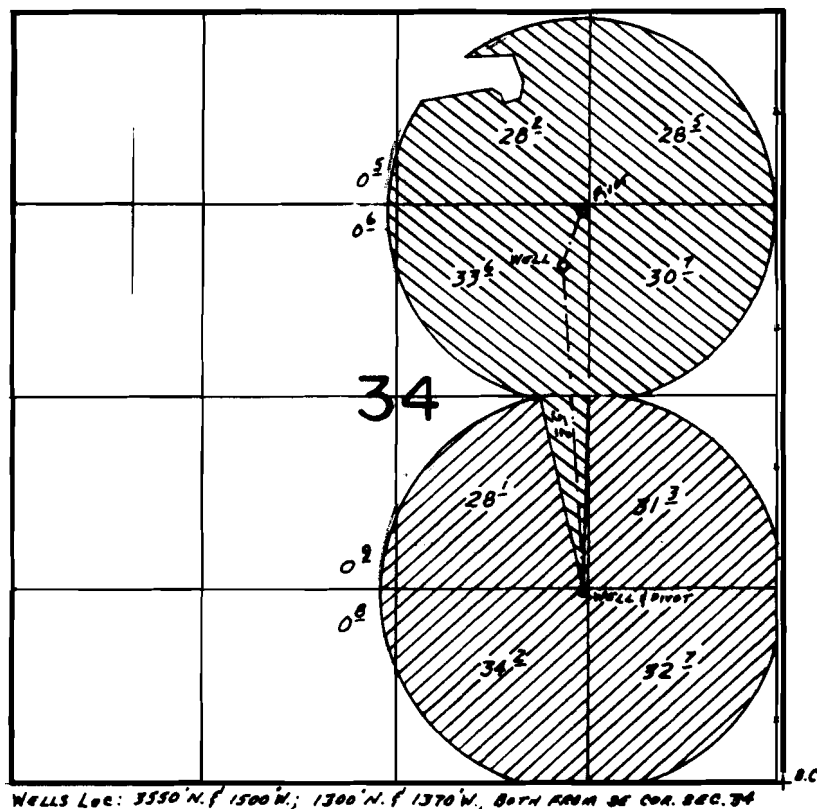

WELLS LOC: 3550' N. of 1500' W.; 1300' N. of 1370' W., BOTH FROM SE COR. SEC. 34

SCALE: 1"=1320'

FINAL PROOF SURVEY **UNDER**

G-10250 G-9292
 Application No. G-10252. Permit No. G-9293.....
 IN NAME OF



.....960 RANCH INC.....

Surveyed OCT. 14... 1984, by B.W. BISHOP.....