


T. 25S., R. 18E., W.M.

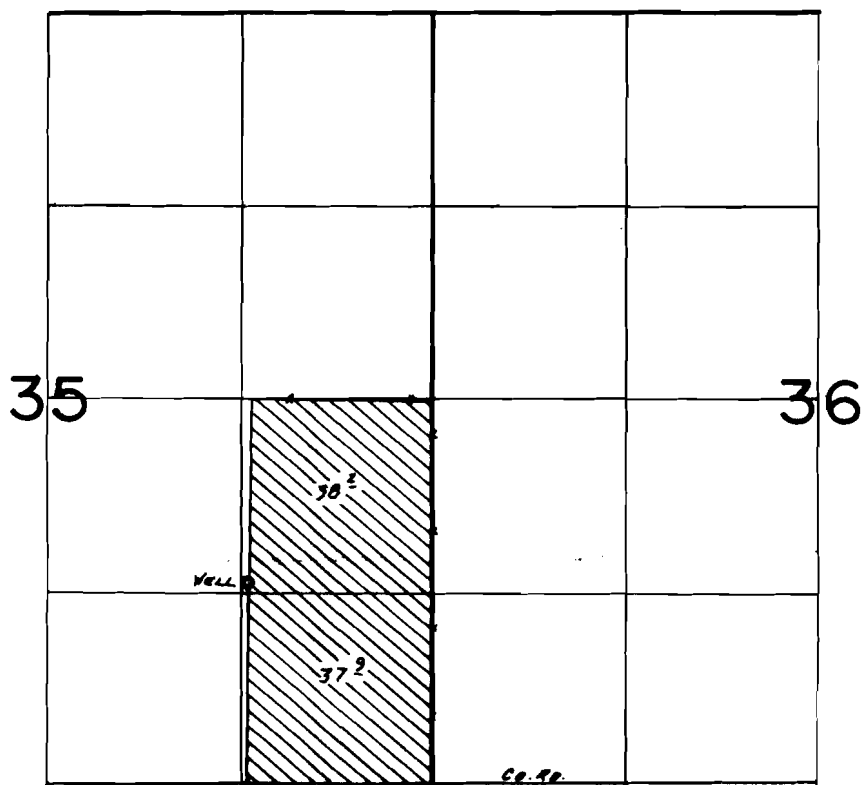

Well Loc: 1400' N. & 1270' W. FROM SE COR. SEC. 35

SCALE: 1" = 1320'

FINAL PROOF SURVEY
UNDER

Application No. G-10985 Permit No. G-10156....
IN NAME OF

.....DAVID M. GOLDBERG.....

Surveyed O.C.T. 13.... 1984, by B.W. BISHOP.....