


T.17S. R.2W. W.M.

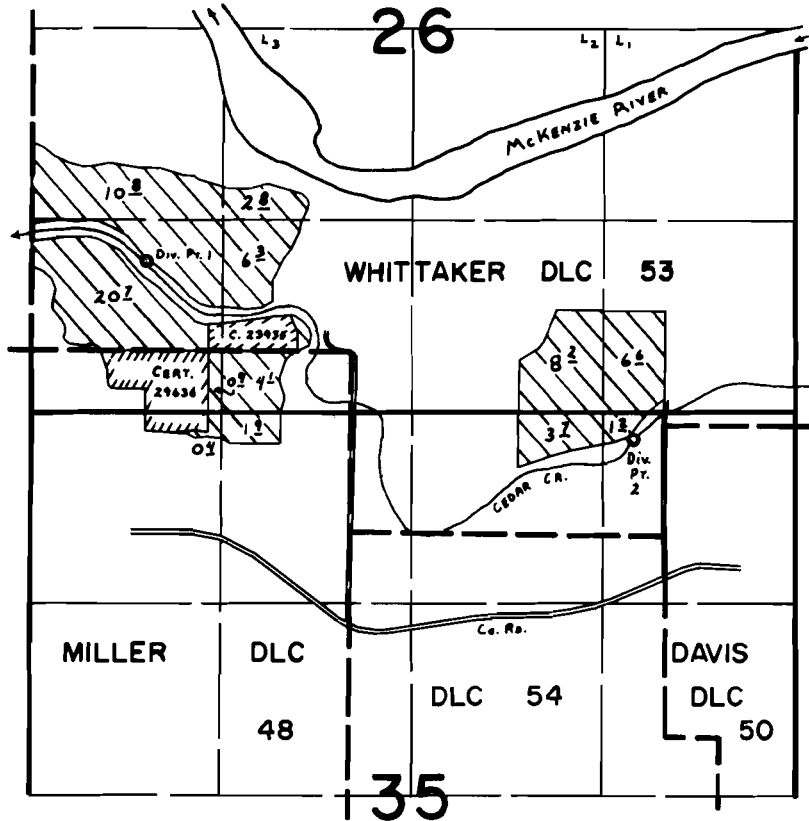

Div. Pts. Loc:
#1- 620' N. & 1900' W. fr. NE COR. MILLER DLC 48.
#2- 90' S. & 210' W. fr. N.W. COR. DAVIS DLC 50.

FINAL PROOF SURVEY
UNDER

Application No. 54619. Permit No. 40982...
IN NAME OF

JAMES L. & MARJORY A. GOSSLER

Surveyed June 21, 1979, by C. L. HUGHES....