


T. 21 S., R. 2 W., W.M.

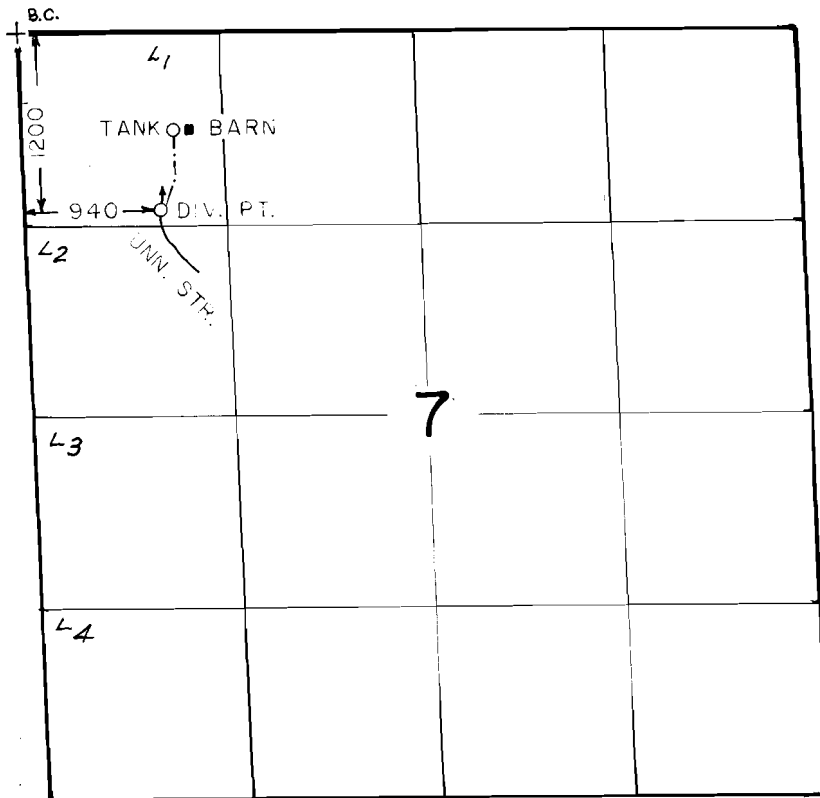

SCALE
1" = 1320'

FINAL PROOF SURVEY
UNDER

Application No. 58062.. Permit No. 43928.....
IN NAME OF

ESTATE OF JAMES H. QUIGLEY

Surveyed AUG 30 1984, by P. PAGTER