


T. 20 S., R. 3 W., WM.

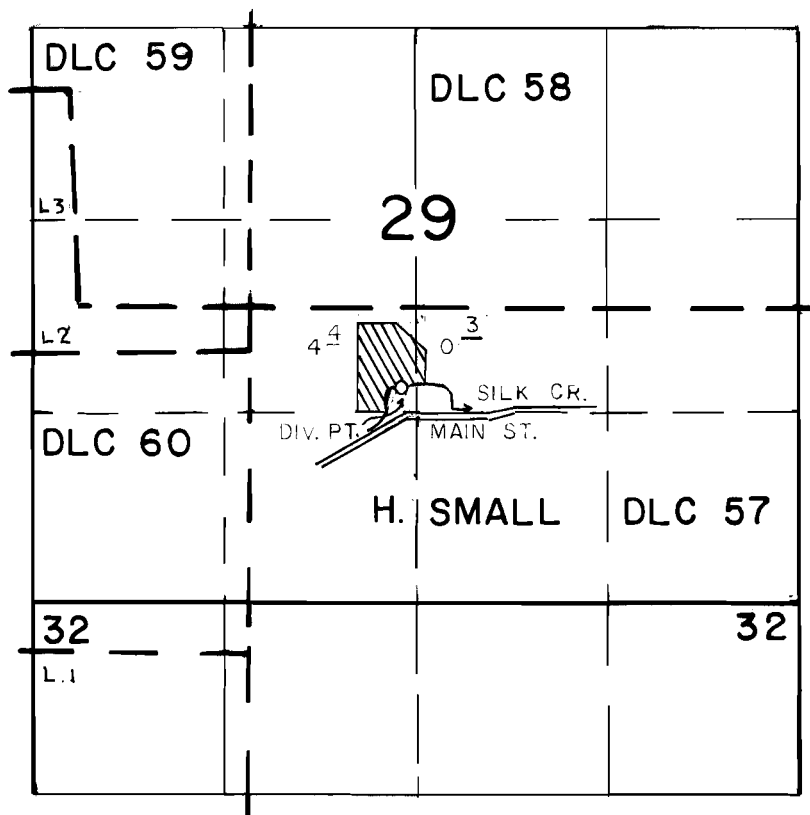

SCALE
1" = 1320'

DIV. PT. LOC. 550' S. & 1050' E OF NW COR. DLC 57

FINAL PROOF SURVEY UNDER

Application No. 61501... Permit No. 45704.....
IN NAME OF

VINCENT FOX.....

Surveyed AUG 29 1984, by P. PAGTER.....