


T.15S. R.38&39E. W.M.

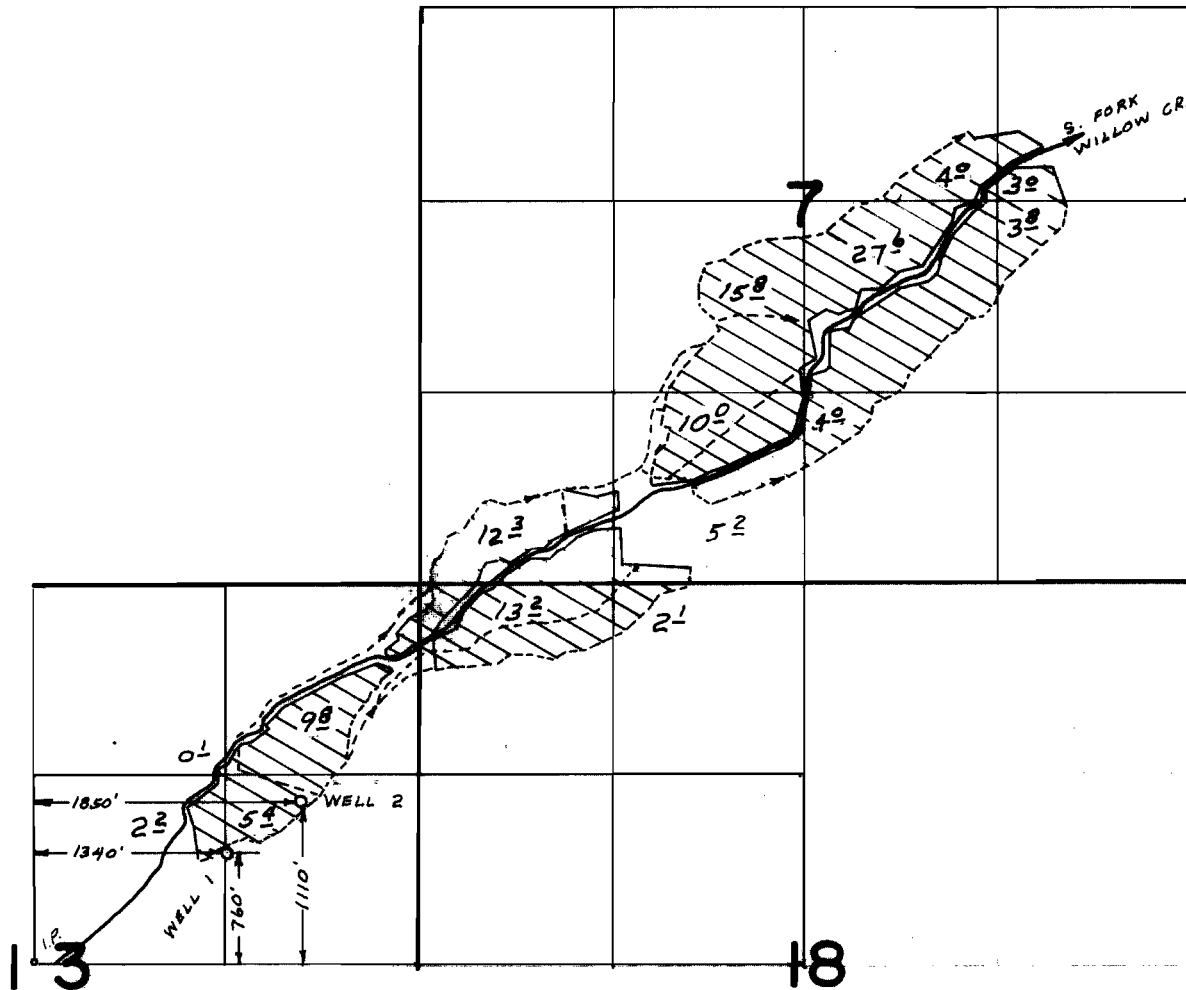

FINAL PROOF SURVEY
UNDER

Application No. G-190 Permit No. G-157
IN NAME OF

ROSS & BERNIECE SIMPSON

Surveyed SEP 25-28 1959, by R.H. JACKSON