



T15S. R.38E.39E. W.M.

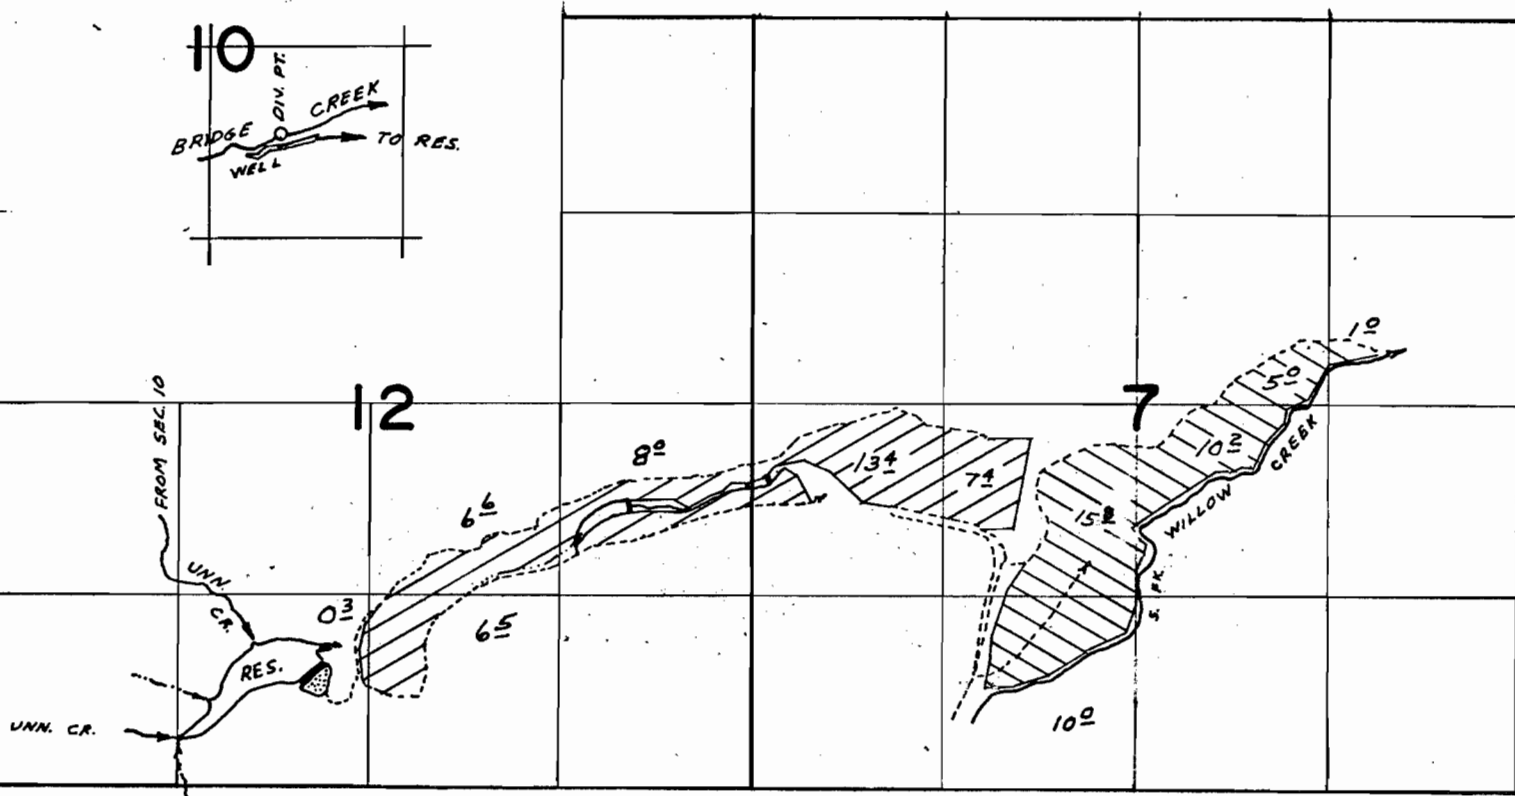

DIV. PT. LOC. 590' S. & 500' E } BOTH FROM CENTER SEC. 10
 WELL LOC. 740' S & 270' E }
 DAM LOC. 1880' S & 410' W FROM CENTER SEC. 12

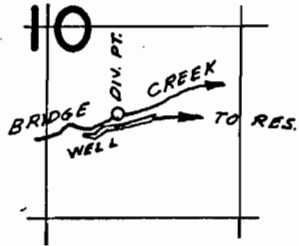

UNDER ALL PERMITS



UNDER ALL PERMITS EXCEPT NO. 17769

FINAL PROOF SURVEY UNDER

	22579	17769
	R-23045	R-931
	23046	18200
Application No.	U-372	Permit No. U-342
IN NAME OF		

.....
 Surveyed JUL. 20. 1953, by H. COFFMAN