


T.6S.,R.1W.,W.M.

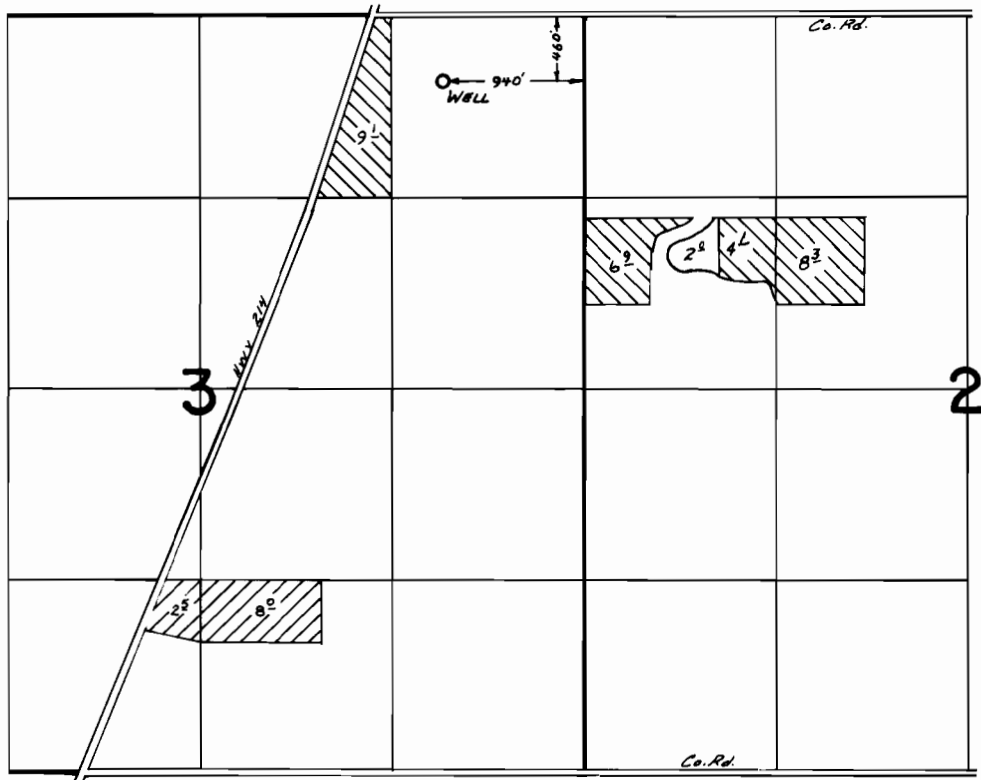

FINAL PROOF SURVEY UNDER

Application No. .G:9732. Permit No. .G:8955....
IN NAME OF

.....**HAROLD KRAEMER**.....

Surveyed .Sept...9... 19.81., by .S..C..BROWN.....