



T. 8S., R. 1E., W. M.

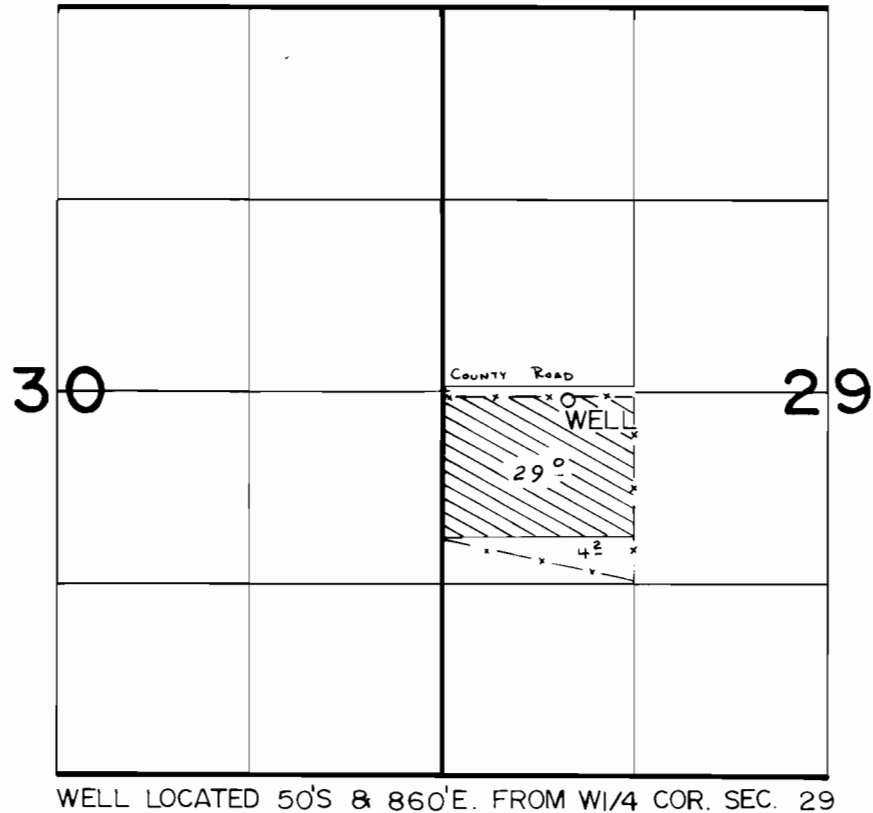

FINAL PROOF SURVEY
UNDER

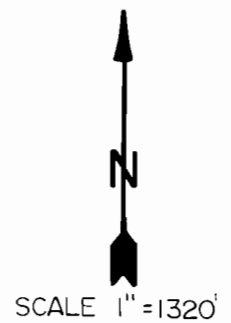

Application No. G:10715..... Permit No. G:9794.....
IN NAME OF

.....**ANTHONY T. HENDRICKS**.....

Surveyed 11-14..... 1984, by B.W. BISHOP.....