


# T.6S., R.1W., W.M.

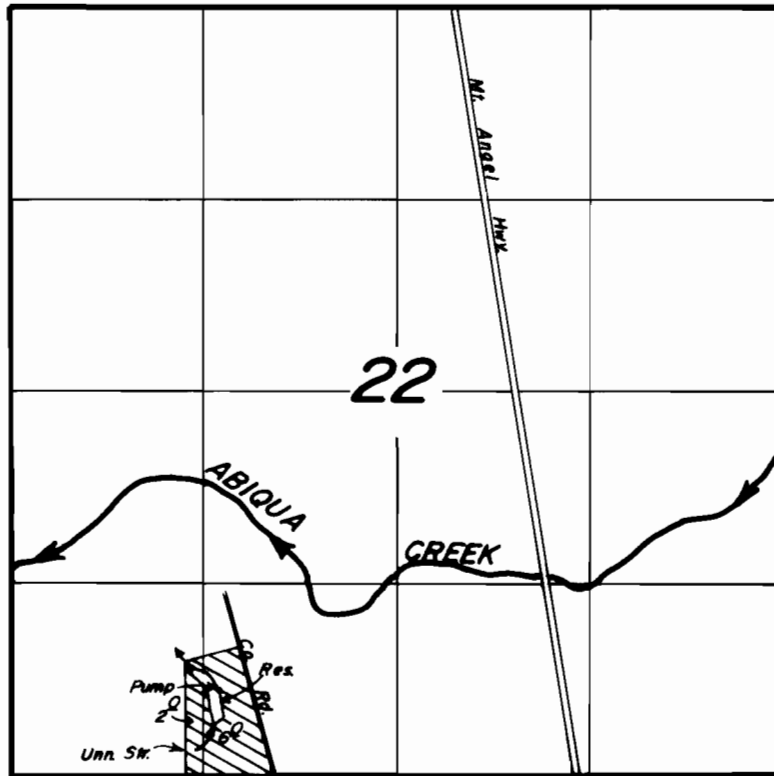

Div. Pt. Loc. : 750' N. & 1210' E. from SW Cor. Sec. 22.

Scale: 1" = 1320'

## FINAL PROOF SURVEY UNDER

R 58980                      R 7980  
Application No. ~~58981~~... Permit No. ~~44602~~.....  
IN NAME OF

**WILLIAM R. ELDER**

Surveyed *May...30.* 19*84*, by *BEN...BISHOP*.....