


T.6S., R.1W., W.M.

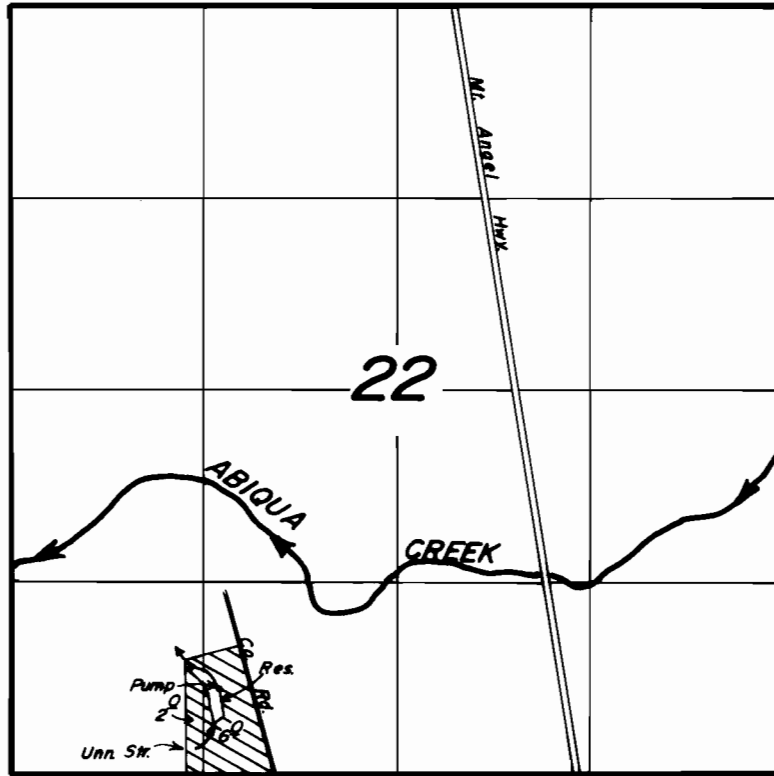

Div. Pt. Loc. : 750' N. & 1210' E. from SW Cor. Sec. 22.

Scale: 1" = 1320'

FINAL PROOF SURVEY UNDER

R 58980 R 7980
Application No. ~~58981~~... Permit No. 44602.....
IN NAME OF

WILLIAM R. ELDER

Surveyed May...30. 19.84, by BEN...BISHOP.....