


T. 5N., R. 27E., W. M.

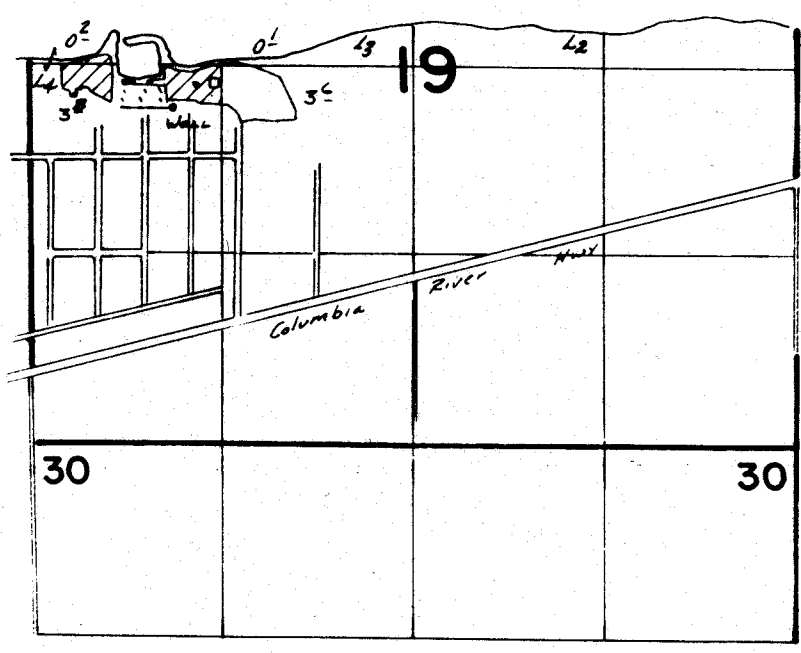

Well Loc: 2290' N. & 1000' E. From SW Cor. Sec 19

FINAL PROOF SURVEY
UNDER

Application No. G:5850 Permit No. G:5727...
IN NAME OF

DEPT. OF THE ARMY, CORPS OF ENGINEERS

Surveyed May 6, 1983, by J.L. Church