


G 5440⁵

53173

T. 6N. R. 35E. W.M.

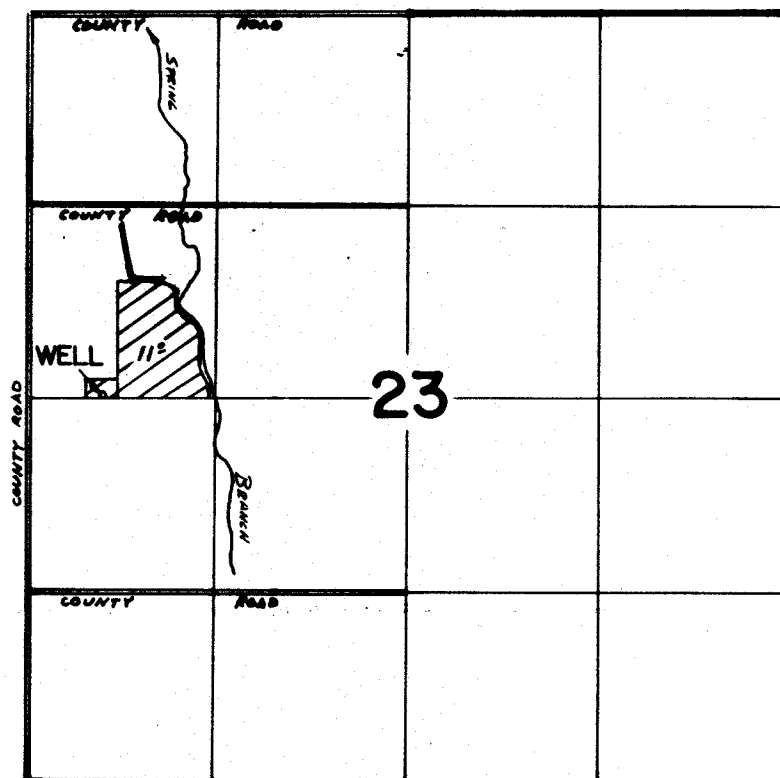

WELL LOCATED 30' N & 2100' W FROM CENTER OF SEC 23

**FINAL PROOF SURVEY
UNDER**Application No. G-5578.. Permit No. G-5440..
IN NAME OF

.....KATHLEEN H. PREST.....

Surveyed 3-29..... 1978, by R. BARWIN.....
1-3 85 V. L. Church

NZ-5MM-29 V.L.C.