


66168 5

53176

T. 2N., R. 33E., W. M.

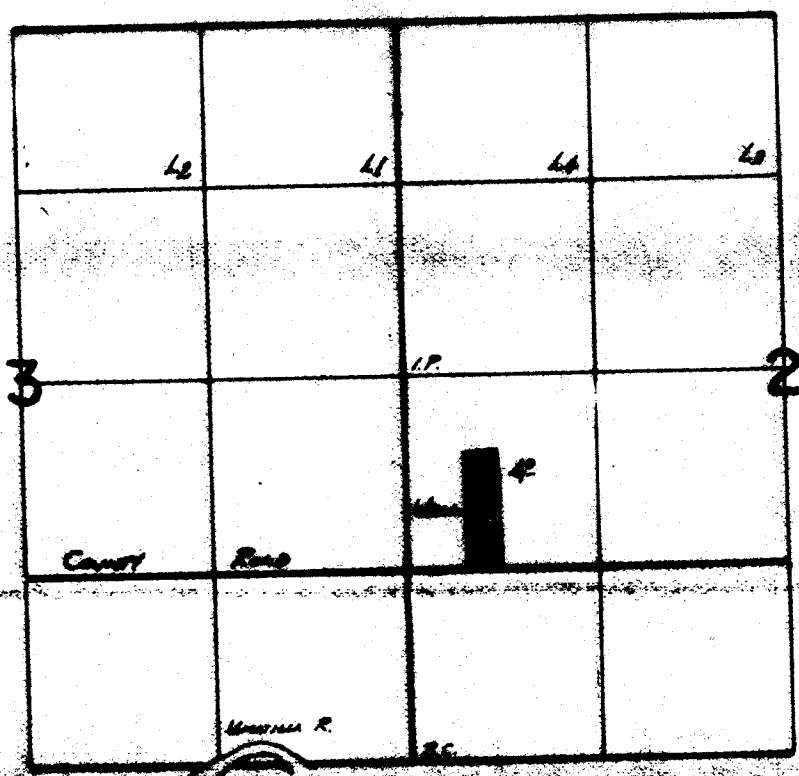

More Loc: 1700' N. & 490' E. From SW Cor. Sec 2

FINAL PROOF SURVEY
UNDER

Application No. G-6568 Permit No. G-6188
IN NAME OF

BRUCE W. COMSTOCK

Surveyed B-4 1982, by *W. Church*