


G7185⁵

53177

T. 2N., R. 31 & 32E., W.M.

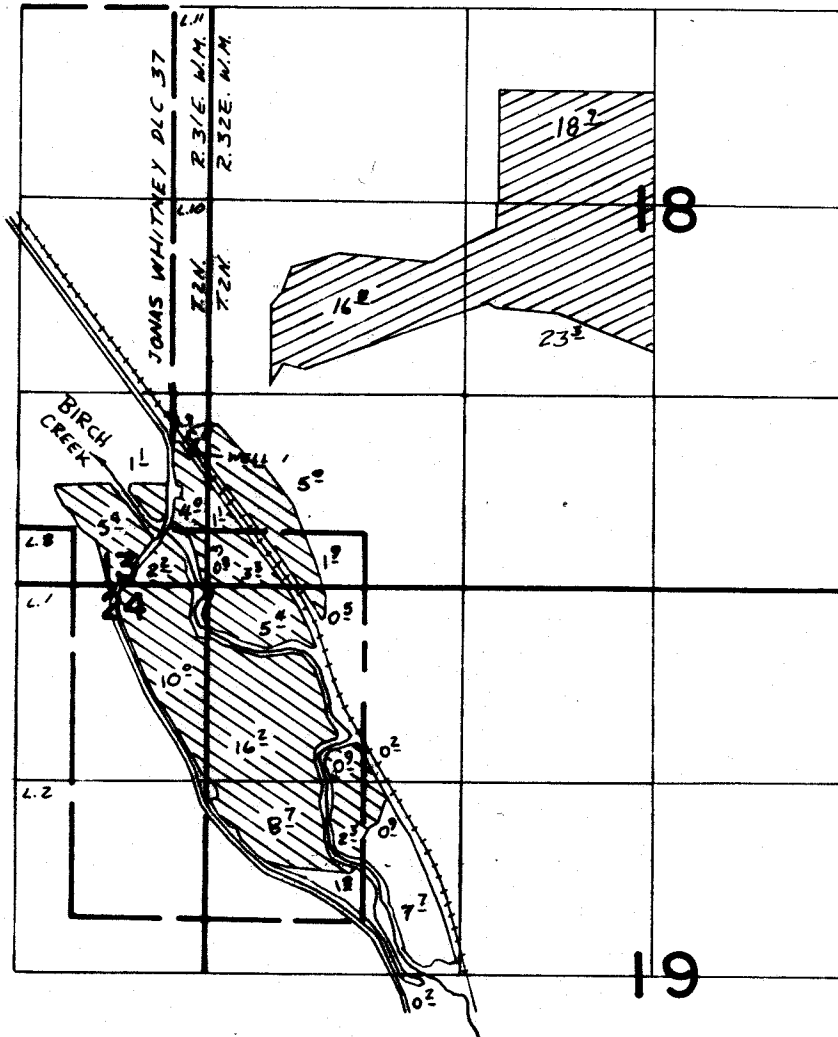

WELL 1 LOCATED 1000' N & 10' W. FROM SE COR SEC 13



PRIMARY



SUPPLEMENTAL

FINAL PROOF SURVEY UNDER

Application No. G:6637. Permit No. G:7185.....
IN NAME OF

JAMES MCBROOM

Surveyed R. 21..... 1978., by R. Barwin.....

PTS-1978-PA
NE-2MM-128 1/16/84 VCC
Revised 12-21-84