


G6877⁵

53179
53202

T. 2N. R. 34E. W.M.

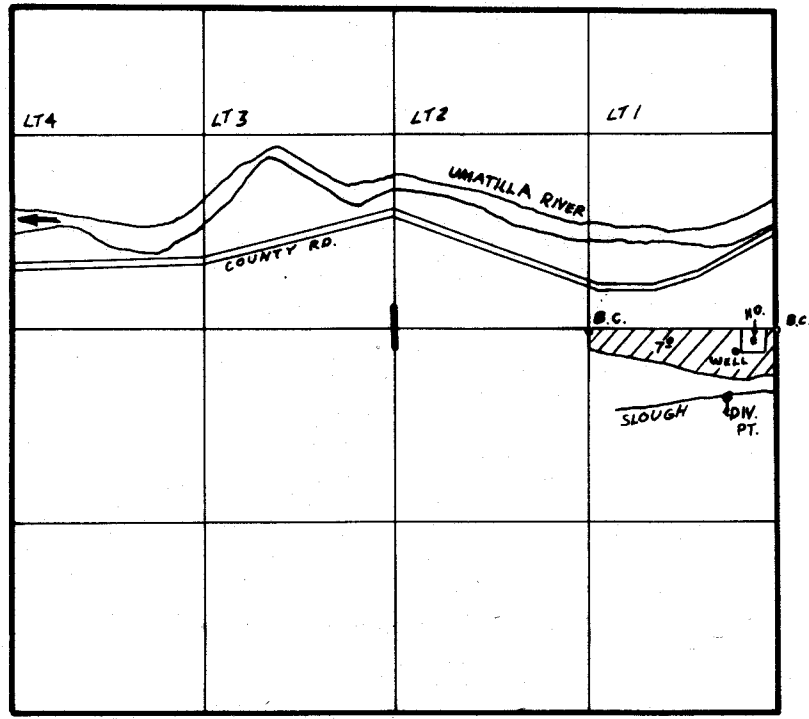

WELL LOCATED 160'S. & 280'W. FROM E.1/4 COR. SEC 1
SLOUGH DIV. PT. 450'S. & 340'W. FROM E.1/4 COR. SEC.1

FINAL PROOF SURVEY
UNDER

G-7420 Application No. 54452... G-6877 Permit No. 40849
IN NAME OF

.....EVELYN..... LANGE.....

Surveyed 7-26..... 1970., by R. BARWIN.....