



G 7276 5
S3182

T 3N., R. 35E., W.M.

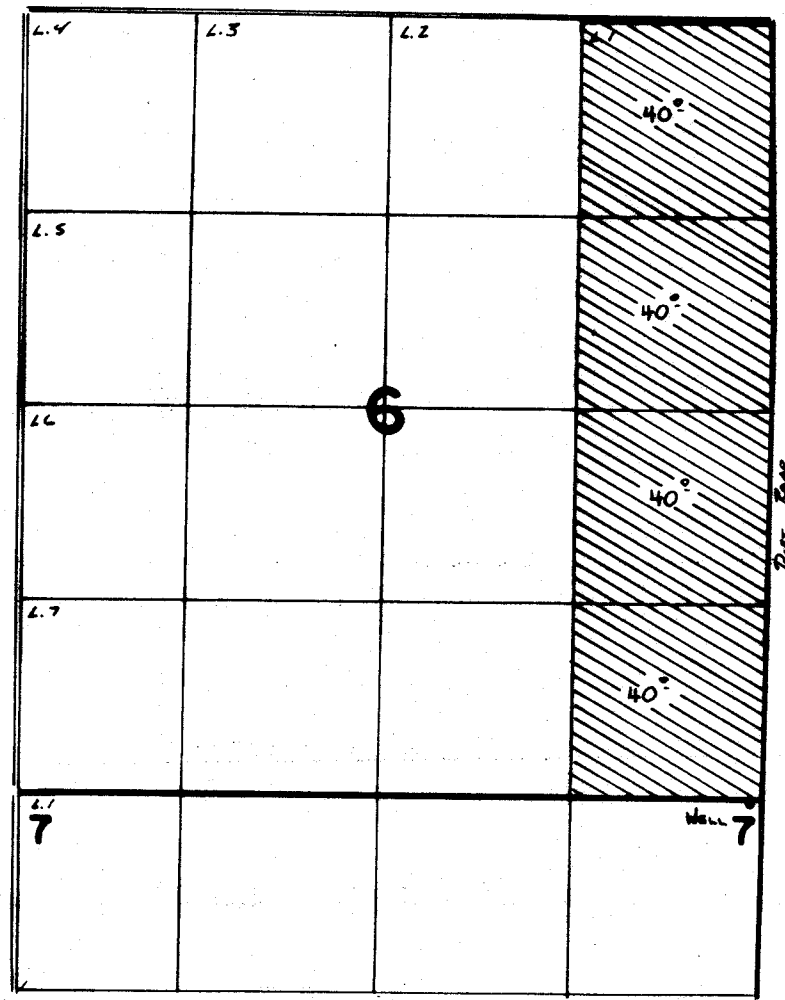

WELL LOCATED 20 FT. S. AND 70 FT. W. FROM NE COR. Sec. 7

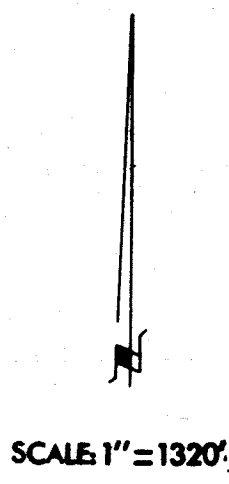

FINAL PROOF SURVEY
UNDER

Application No. **G:7841** Permit No. **G:7276**
IN NAME OF
B. L. DAVIS RANCH, INC.
Surveyed Jan. 3, 1985, by V. L. Church