


G7747 5
53185

T. 5 N., R. 29 E., WM.

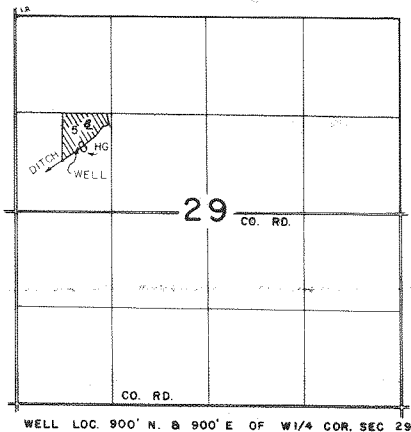

SCALE
1" = 1320'

FINAL PROOF SURVEY
UNDER

Application No. G-8354 Permit No. G-7747
IN NAME OF

MERTON E. WHITEHALL

Surveyed MAR 31, 1978, by R. BARWIN