


68548

57184

T. 4N., R. 28E., W.M.

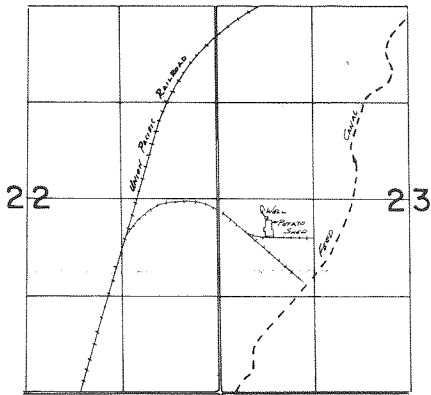

Well Loc: 240'S. &amp; 660'E. From NW Cor Sec 23

**FINAL PROOF SURVEY**  
UNDER

Application No. G:9110 ... Permit No. G:8548  
IN NAME OF

MIKAMI BROTHERS POTATOES

Surveyed Aug. 18, 1932, by *V.L. Chasch*