


T. 3N., R. 30E., W.M.

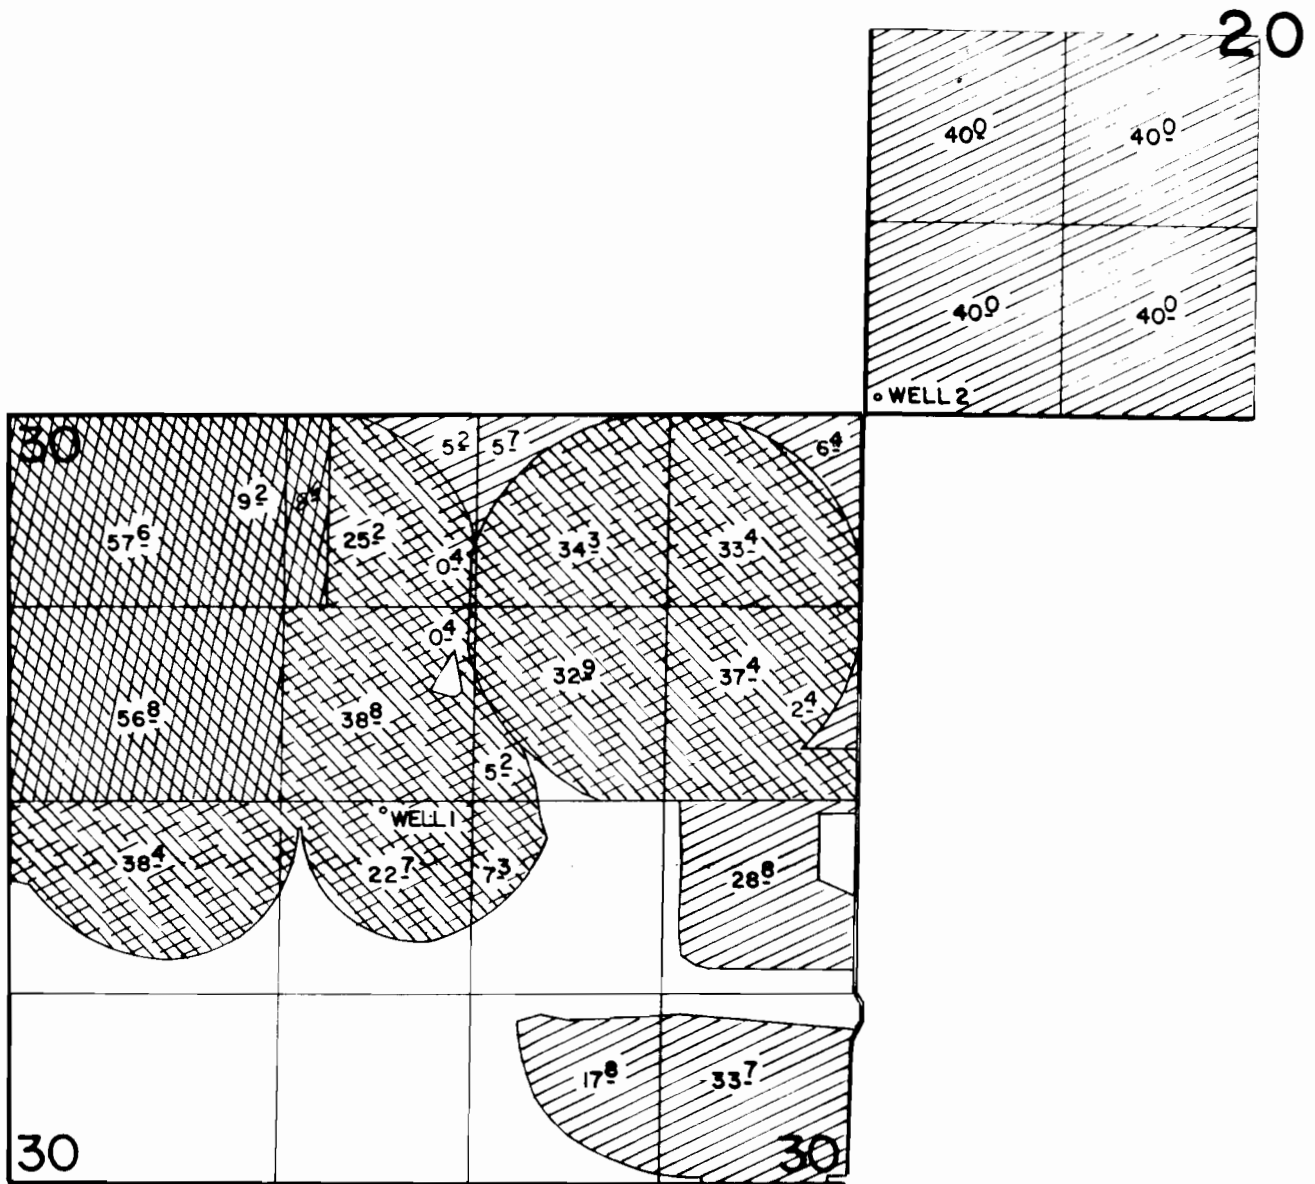

WELL 1 LOCATED 30'S. & 640'W. FROM CENTER COR. SEC. 30
 WELL 2 LOCATED 100'N. & 80'E. FROM S.W. COR. SEC. 20

FINAL PROOF SURVEY

UNDER

G-8910

G-7153

Application No. **G-8658** Permit No. **G-8041**....

IN NAME OF

.....**DAVID L. STEIN**.....

Surveyed *APRIL 3* 19*84*, by *V.L. Church*.....

PRIMARY



SUPP'L

