


# T. 3N., R. 30E., W.M.

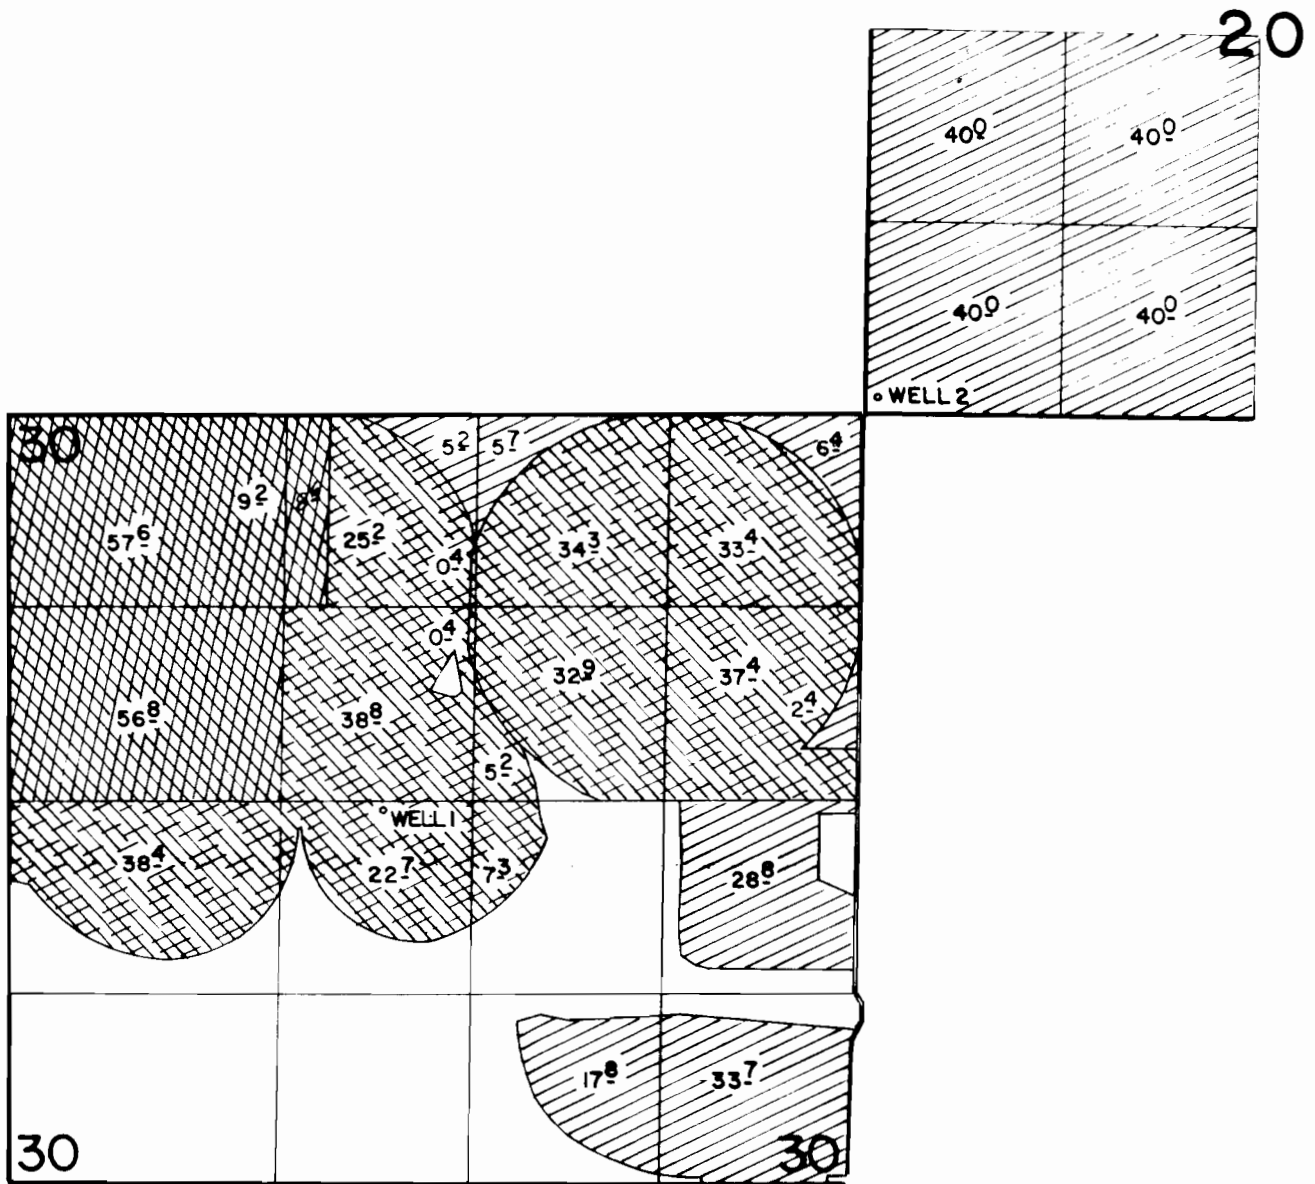

WELL 1 LOCATED 30'S. & 640'W. FROM CENTER COR. SEC. 30  
 WELL 2 LOCATED 100'N. & 80'E. FROM S.W. COR. SEC. 20

## FINAL PROOF SURVEY

UNDER

G-8910

G-8367

G-7153

G-6600

Application No. G-8658 Permit No. G-8041...

IN NAME OF

.....DAVID L. STEIN.....

Surveyed APRIL 3 1984, by V.L. Church.....

PRIMARY



SUPP'L

