


T. 2N., R. 30E., W.M.

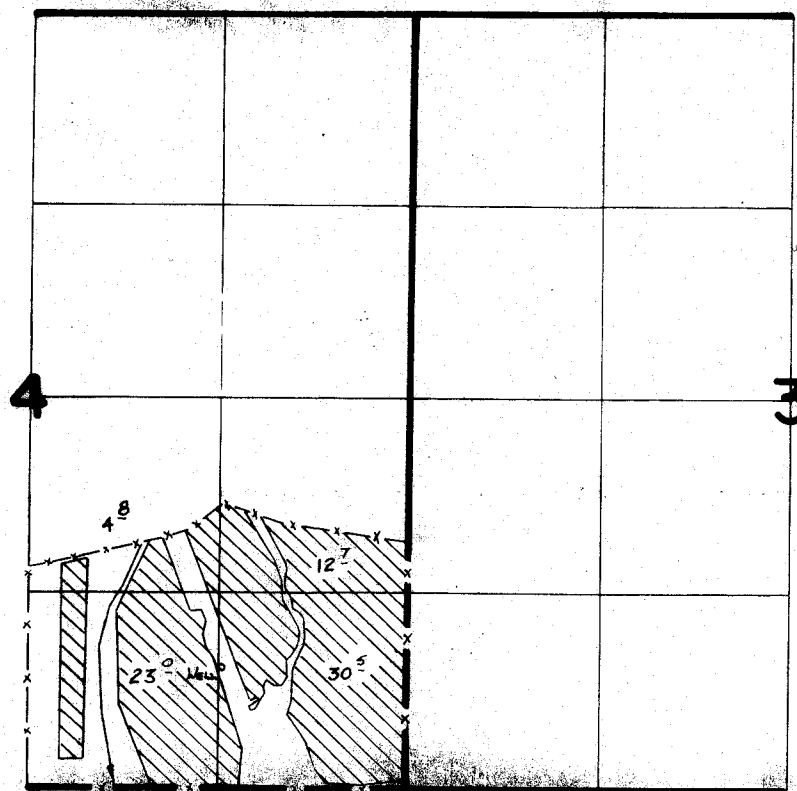

WELL LOCATED 820' N 1290' W. FROM SE COR SEC 4

FINAL PROOF SURVEY
UNDERApplication No. G: 8987. Permit No. G: 8370...
IN NAME OF

BOB HINES

Surveyed March 15, 1983, by V. L. Chiswick