G 6200 5

53191

T. 2N. R. 30E. W.M.

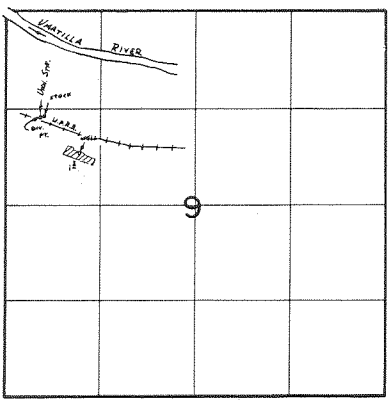

WELL LOC. 720'N & 1010'E FROM W1/4 COR OF SEC 9

DIV. PT. LOC. 1210'N & 470'E FROM W1/4 COR OF SEC 9

FINAL PROOF SURVEY

UNDER

Application No. G-56016 Permit No. G-42122

IN NAME OF

YGNACIO PEDRO ARISTEQUI

Surveyed X-17 19 78, by R. BARWIN

PTS-1978-P-A V.L.G. 10-3-78