


T. 3N. R. 37E. W.M.

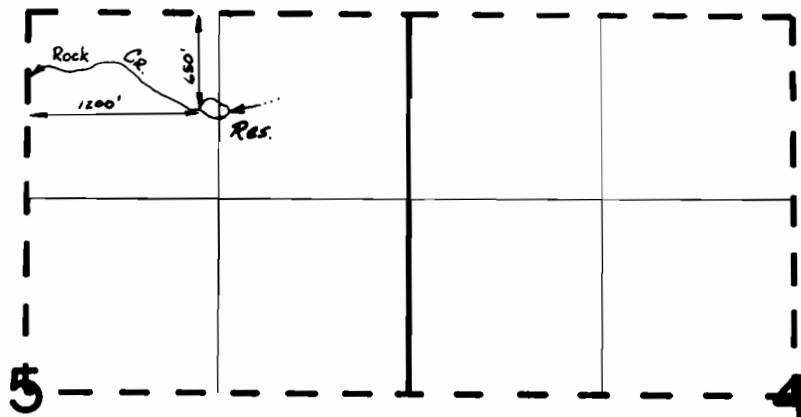

FINAL PROOF SURVEY
UNDER

Application No. ⁴³¹⁰⁸ R-43107. Permit No. ³²²¹⁴ R-4916....
IN NAME OF

.....**RAY CARTER**.....

Surveyed 9-21..... 1978, by R. BARWIN.....