


T. 4N., R. 29E., W. M.

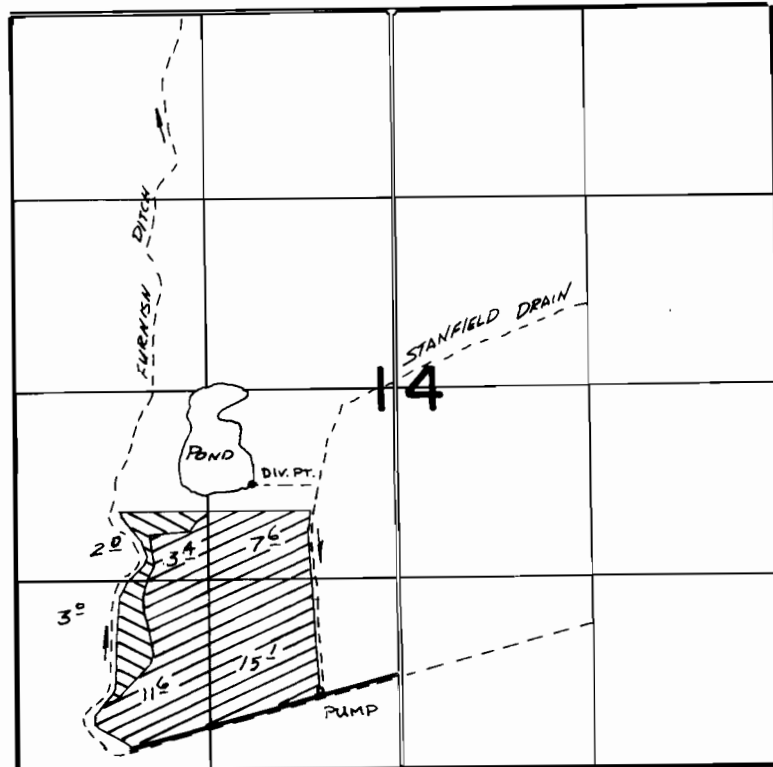

DIV. PT. LOC: 640'S. & 990'W. FROM CENTER COR. SEC. 14

 PRIMARY  SUPPLEMENTAL

**FINAL PROOF SURVEY**  
UNDER

Application No. **52850** Permit No. **39893**...  
IN NAME OF

.....**LEONARD.....LORENZEN**.....

Surveyed *Aug 3*..... 19*82*., by *V.R. Church*.....