


53207

P-40171

T.10S. R.23E. W.M.

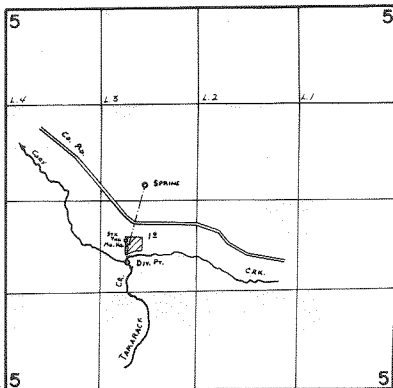

DIV. PT. LOC: 840'S. & 960'W. } BOTH FROM CENTER 1/4 COR. SEC. 5.
 SPRING LOC: 210'N. & 730'W. }

FINAL PROOF SURVEY

Application No. 51299 Permit No. 38736
53809 40171
 IN NAME OF

LEWIS BRATTON

Surveyed July 25, 1979, by C. L. HUGHES