


T. 2 S., R. 3 W., WM.

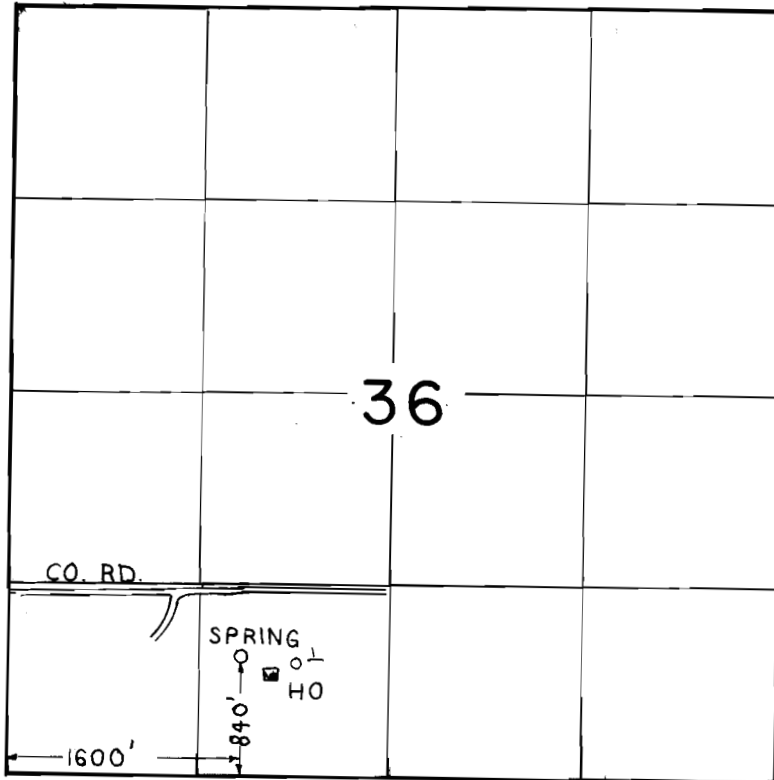

SCALE
1" = 1320'

FINAL PROOF SURVEY
UNDER

Application No. 57144.. Permit No. 43078.....
IN NAME OF

THOMAS G. ROHDE.....

Surveyed AUG 20, 1984, by P. PAGTER.....

with new survey