



T.4S., R.3W., W. M.

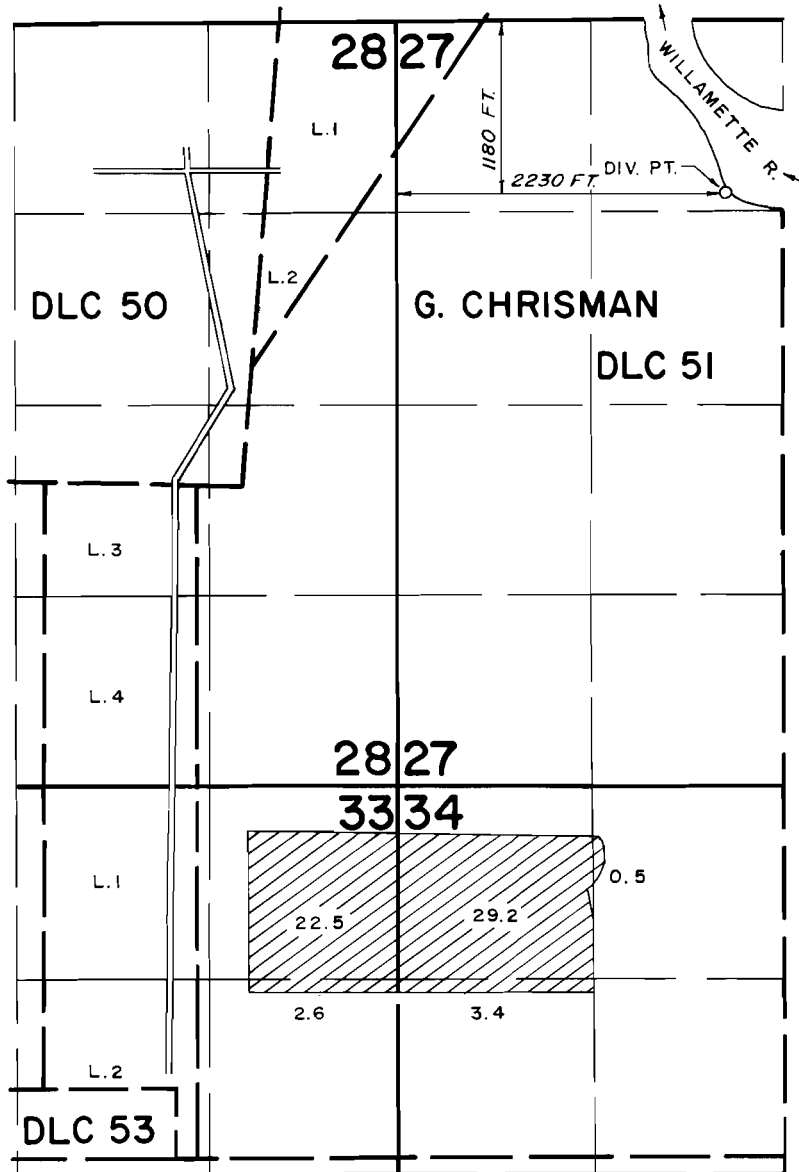

FINAL PROOF SURVEY UNDER

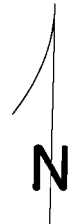

SCALE: 4" = 1 MILE

Application No. 58220 Permit No. 43925
IN NAME OF

STEVE WILSON

Surveyed MAY 16, 1984, by P. Patten