


T. 28 S., R. 13 W., W.M.

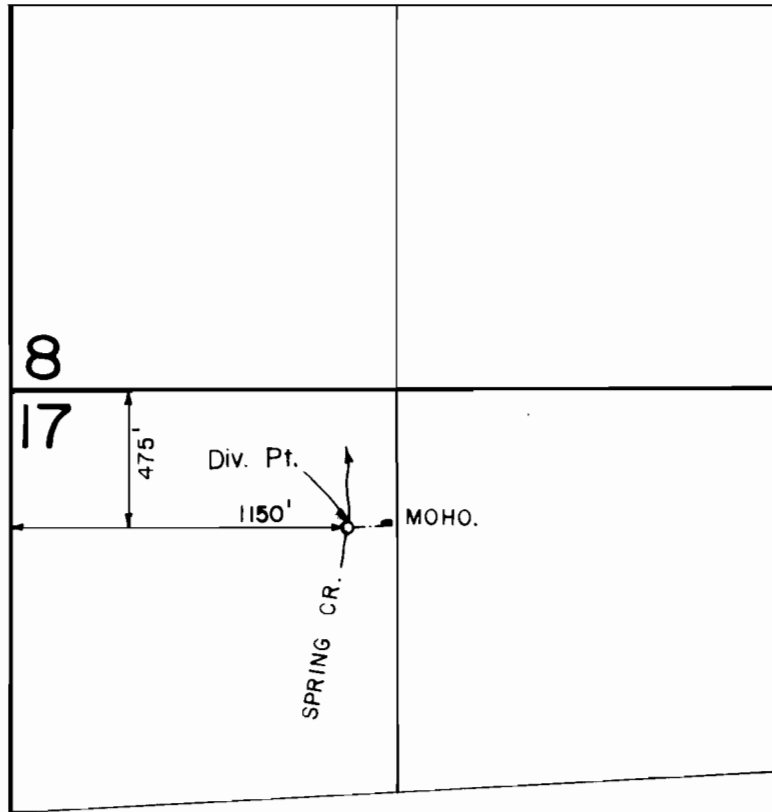

SCALE: 1" = 660'

FINAL PROOF SURVEY
UNDER

Application No. 55204. Permit No. 41408.....
IN NAME OF

WILLIAM T. ADAIR.....

Surveyed APR. 18 1978, by B. R. SUND.....