


T. 28 S. R. 14 W. W. M.

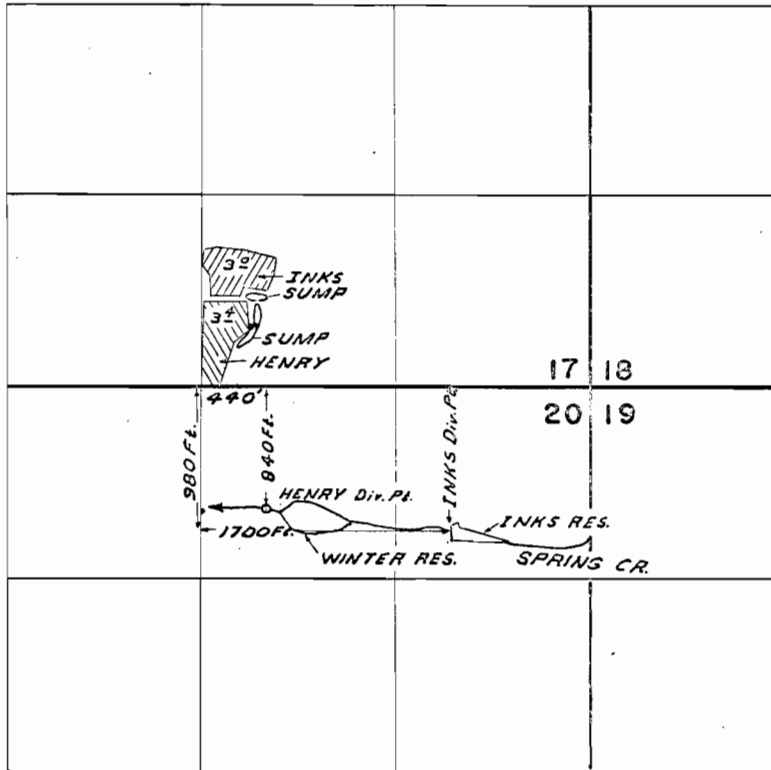

Application No. 42022

Permit No. 31526

FINAL PROOF SURVEY  
UNDER

R-35040

R-2238

Application No. ~~33041~~ Permit No. ~~26134~~  
IN NAME OF

H.R. INKS & R.M. HENRY

Surveyed AUG 24 1965, by L. COLEBANK