


T. 13 S., R. 9 E., W.M.

SECTION 15

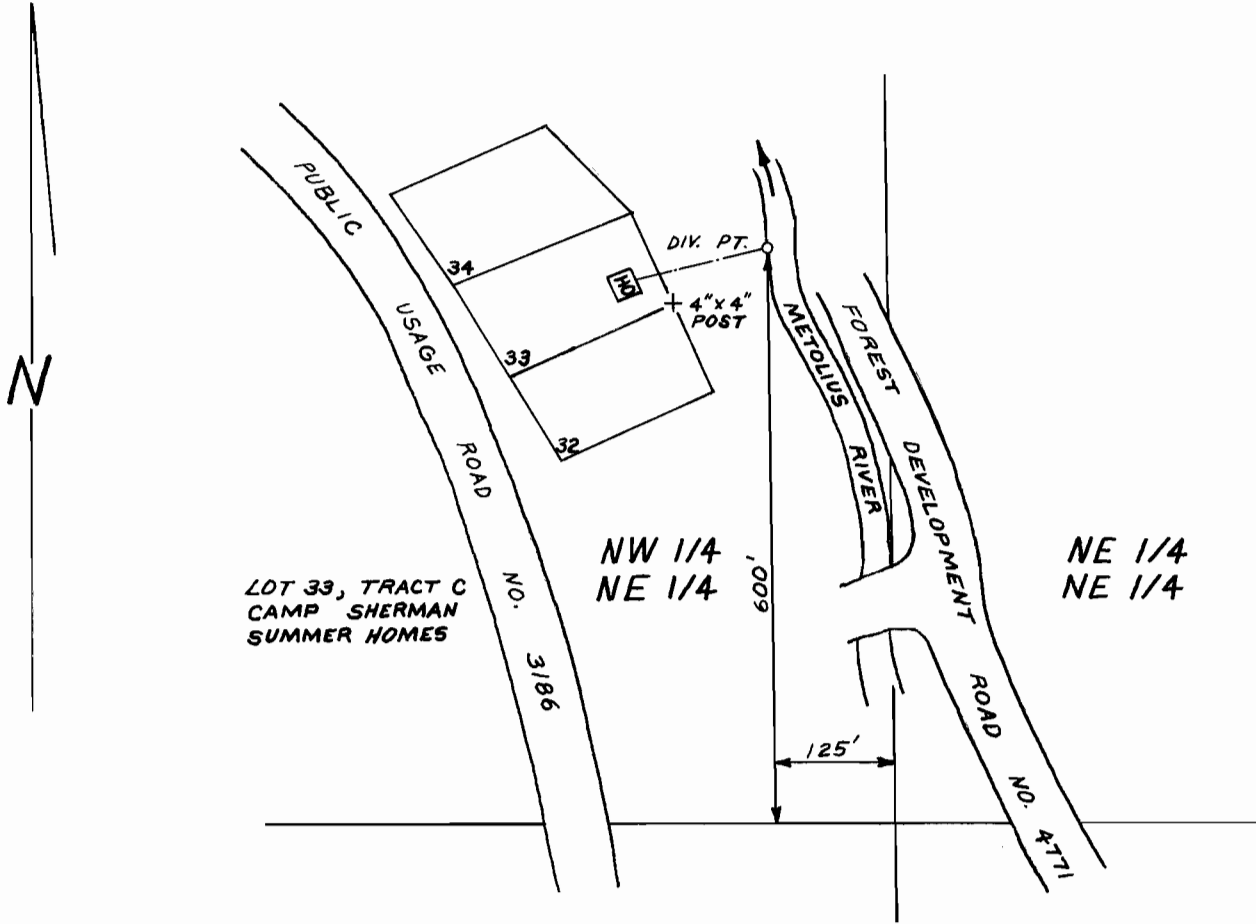

SCALE: 1" = 200'

FINAL PROOF SURVEY

UNDER

Application No. 65221 Permit No. 47909

IN NAME OF

ROBERT E. SCOTT

Surveyed APRIL 2, 1985, by LESLIE OLSON