


T.30S. R.2W. W.M.

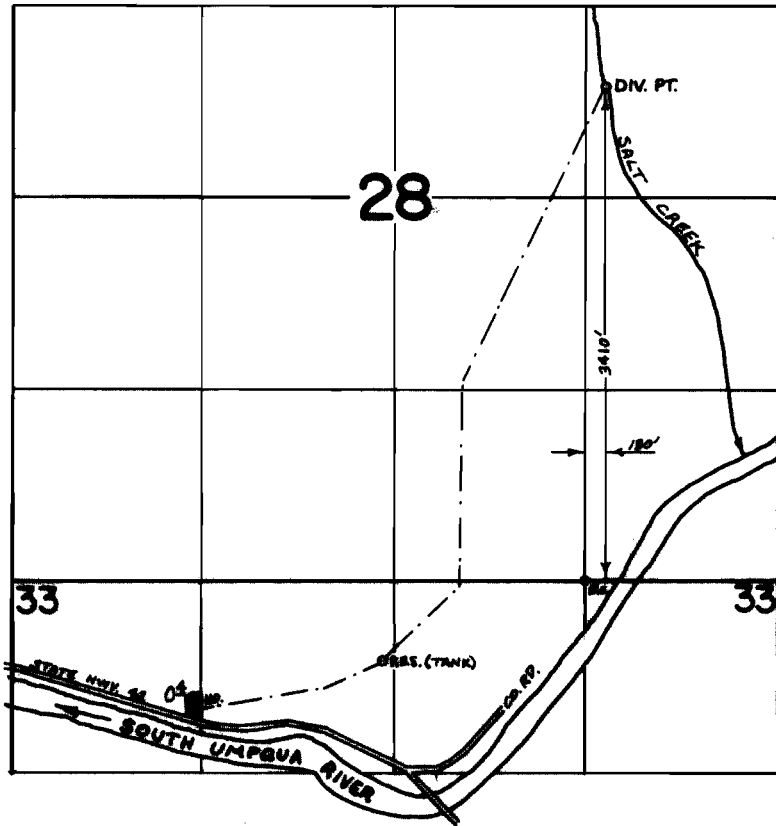

FINAL PROOF SURVEY
UNDER

Application No. 45819 Permit No. 34191
IN NAME OF

W.S. & R.M. MOUNT

Surveyed MAY 23 1975, by L. TOLL