

T. 29S., R. 4W., W.M.


B.C.  
N 1/4 COR.  
SEC. 29

SEC 29

NENW



SCALE: 1" = 400'

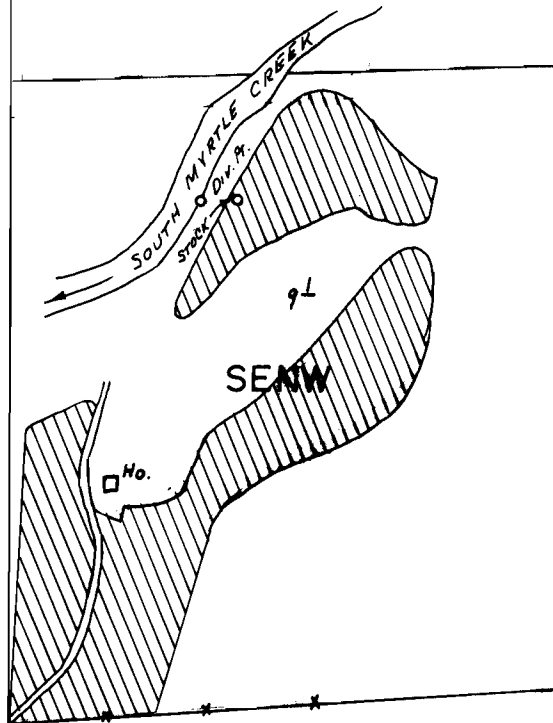

*Div. Pt. Loc.: 1580' S. & 800' W. FROM N 1/4 COR. SEC. 29*

**FINAL PROOF SURVEY**  
UNDER

Application No. 56351... Permit No. 42390...  
IN NAME OF

...GENE B. & EVELYN R. GARY...

Surveyed June 12... 1980, by J.S. DONALDSON.

1/24/85 JEC  
1/1/85  
DOB. Co. 77-28-21