


T. 26S., R. 6W., W.M.
SEC. 22

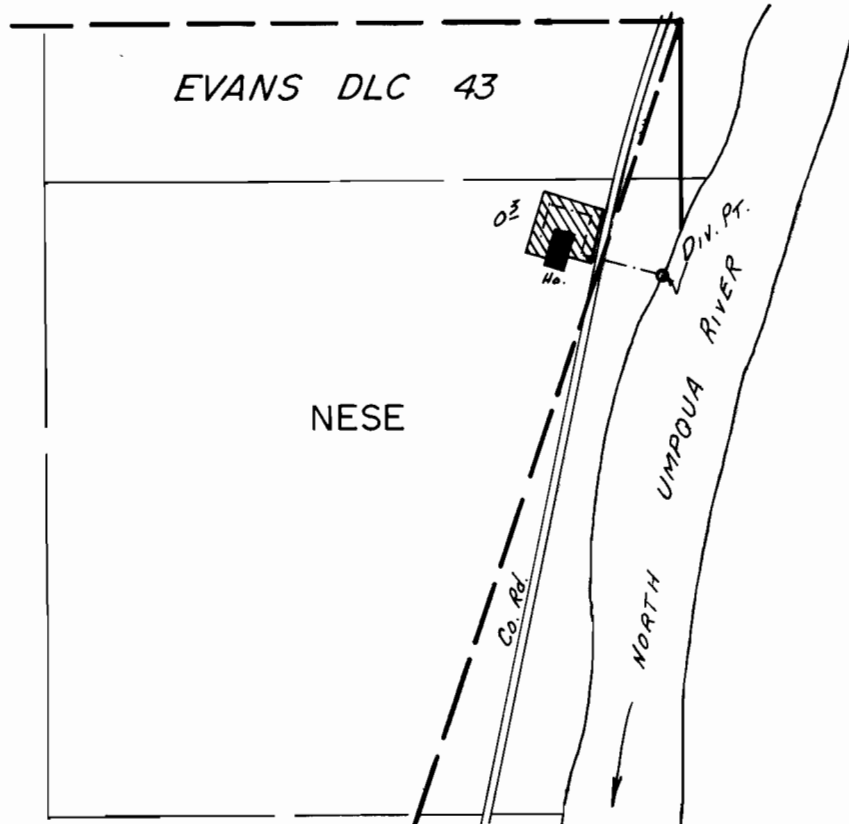

Div. Pt. Loc.: 530 S. & 40 W. FROM NE COR. EVANS DLC 43.

SCALE: 1" = 400'

FINAL PROOF SURVEY
UNDER

Application No. 57961... Permit No. 43595.....
IN NAME OF

.....Charles D. Zeits.....

Surveyed MAY 2..... 1979, by J.S. DONALDSON