


T. 40 S., R. 3 W., W.M.

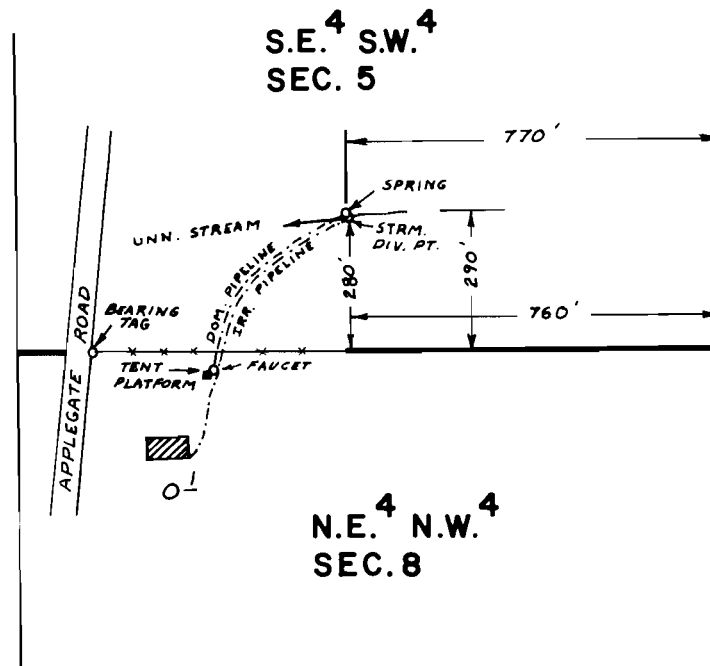

SCALE: 1" = 400 FT.

FINAL PROOF SURVEY
UNDER

Application No. 50655 Permit No. 37654
IN NAME OF

STRIBLEY A. SCHUSSMAN

Surveyed APR. 24 1979 by B. SUND