


T.37S.,R.5W.,W.M.

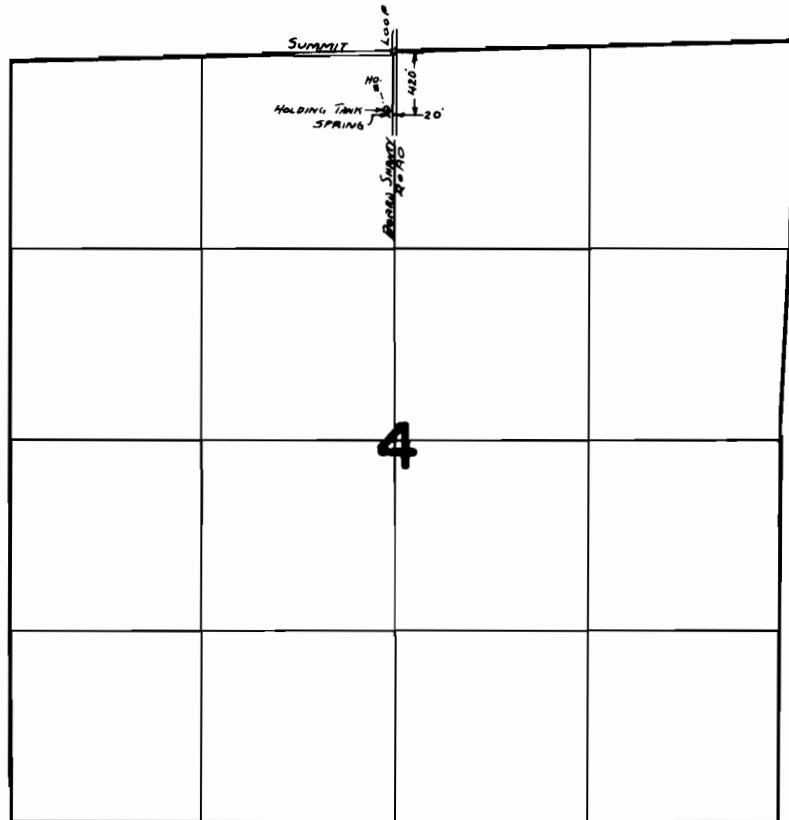

FINAL PROOF SURVEY
UNDER

Application No. 51926 Permit No. 39066
IN NAME OF

RAYMOND T. SILVER, JR.

Surveyed MAY 1 1976, by L. TOLL