


T.27S.,R.17E.,W.M.

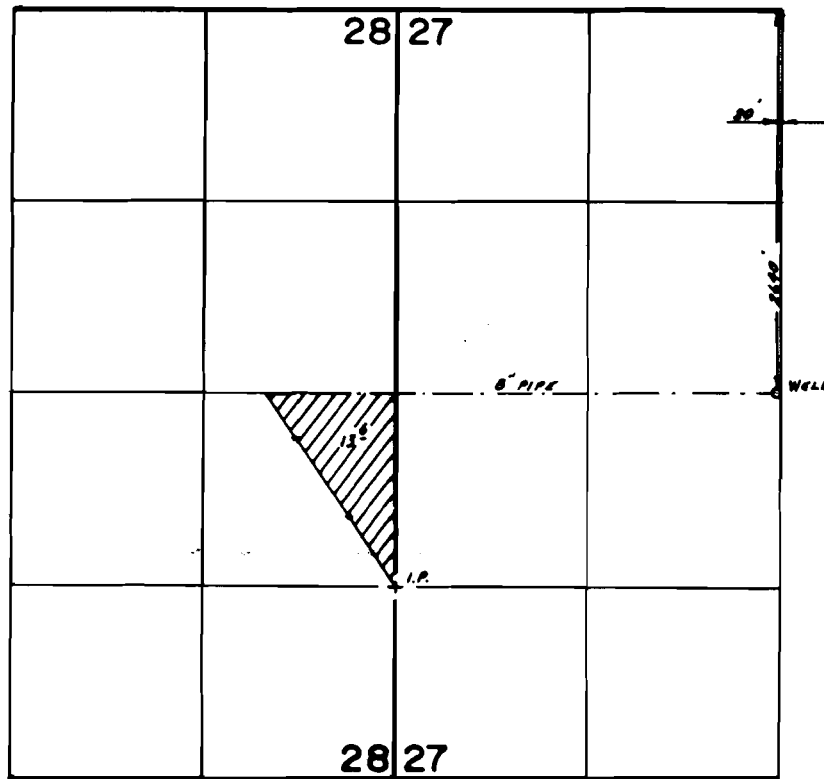

**FINAL PROOF SURVEY**  
UNDER

Application No. G-11210... Permit No. G-10297....  
IN NAME OF

.....**DAVID A. SEIBEL**.....

Surveyed Q.C.T. 17.... 19.84, by B.W. BISHOP.....