


T. 20 S., R. 5 W., W.M.

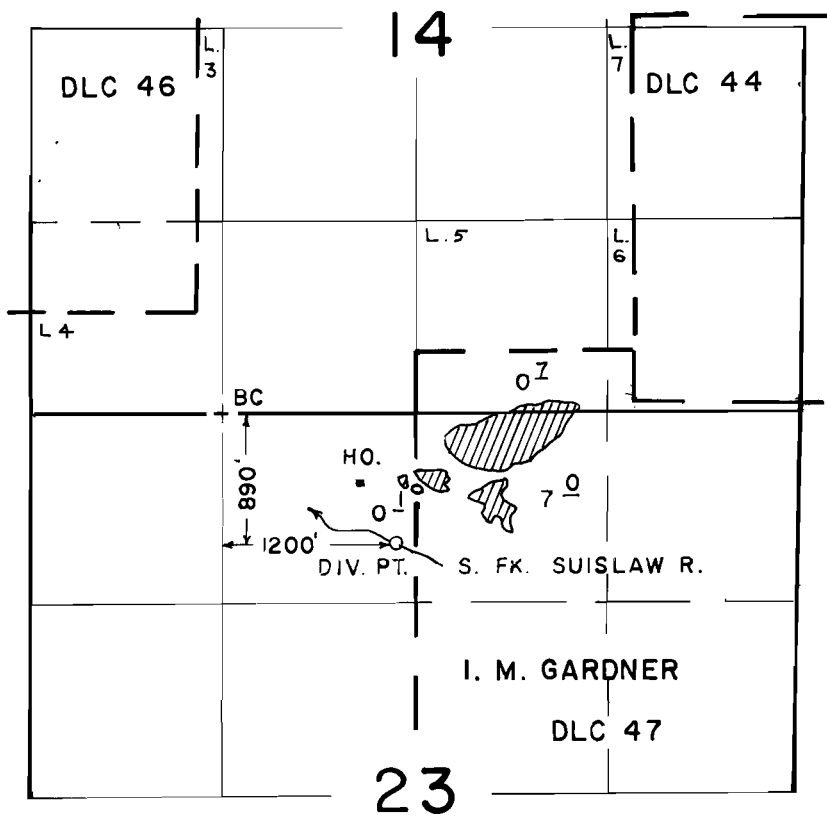

**FINAL PROOF SURVEY**  
UNDER

Application No. 55816.. Permit No. 41879.....  
IN NAME OF

.....CURTIN MITCHELL.....

Surveyed SEP. 25. 1984, by .P. PAGTER.....