


T. 20 S., R. 3 W., WM.

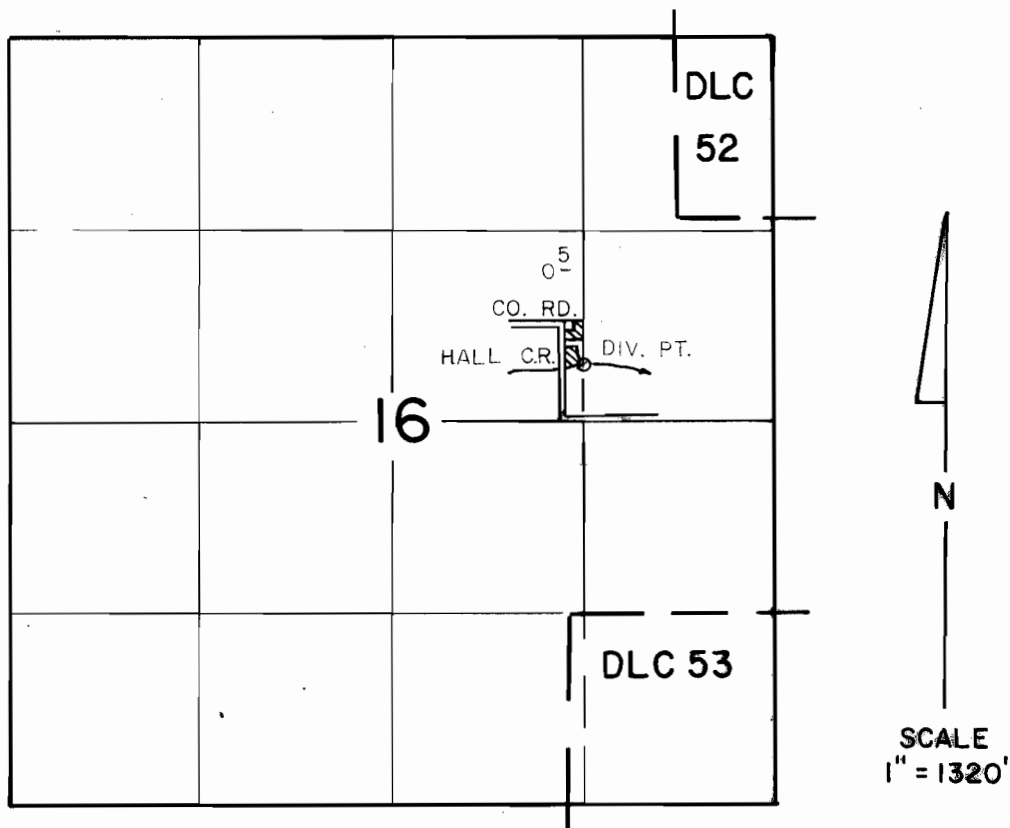

DIV. PT. LOC. 2250' S & 1320' W OF NE COR. SEC 16

FINAL PROOF SURVEY UNDER

Application No. 58608... Permit No. 44191.....
IN NAME OF

GARTH R. DEGARLAIS & EARL L. COOPER

Surveyed AUG 29, 1984, by P. PAGTER.....