


# T. 1 S., R. 2 W., W. M.

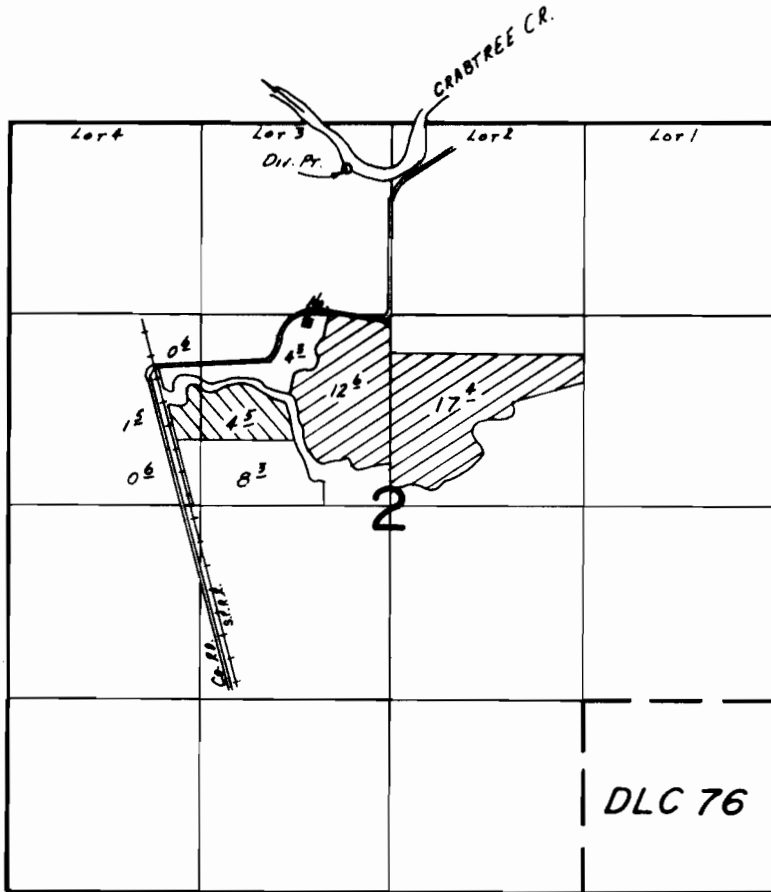

Div. Pr. Loc: 2310' N. & 300' W. FROM CENTER 1/4 COR. SEC. 2.


SCALE: 1" = 1320'

## FINAL PROOF SURVEY UNDER

54041

40418

Application No. 61344.. Permit No. 45639.....  
IN NAME OF

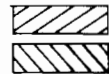

.....HAROLD K. REILEY.....

Surveyed MAY. 28.. 19.82, by L.M.TOLL.....